

CONSTRUCTION PHASING


JOB NUMBER: 1191
SHEET:


G2

CONSTRUCTION PHASING DIAGRAMS

© AXIA ARCHITECTS

ORIGINAL DATE:

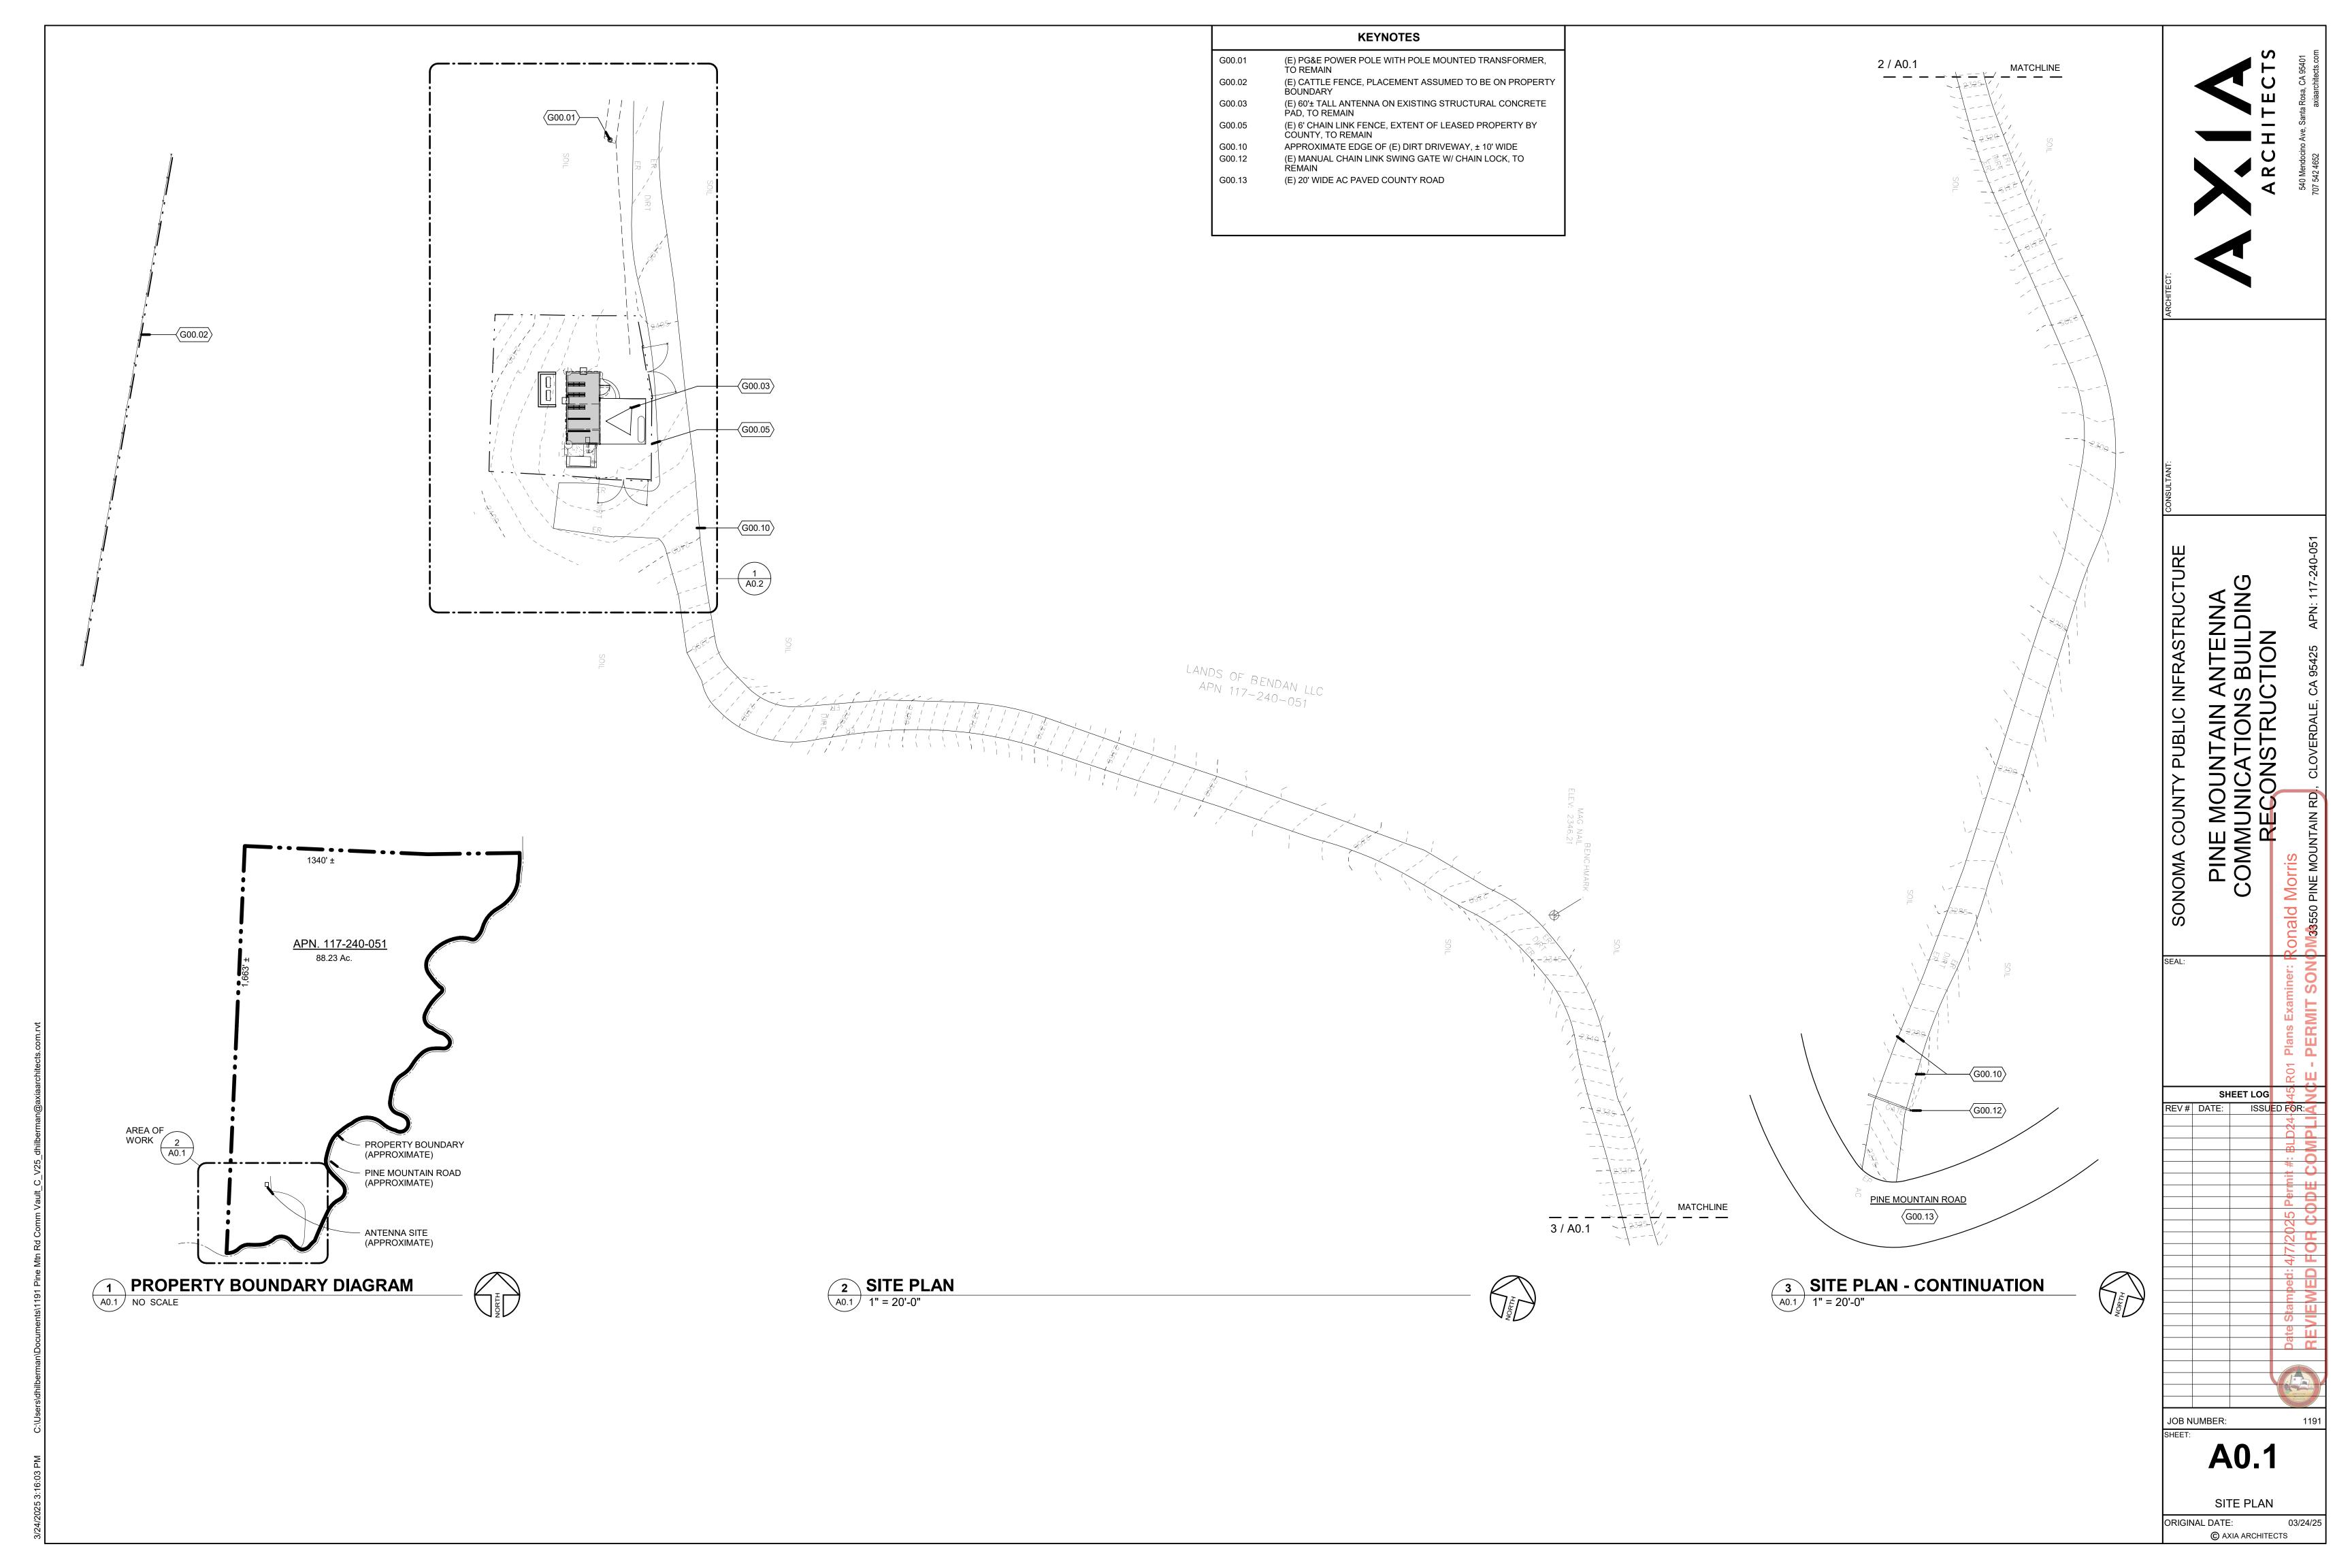

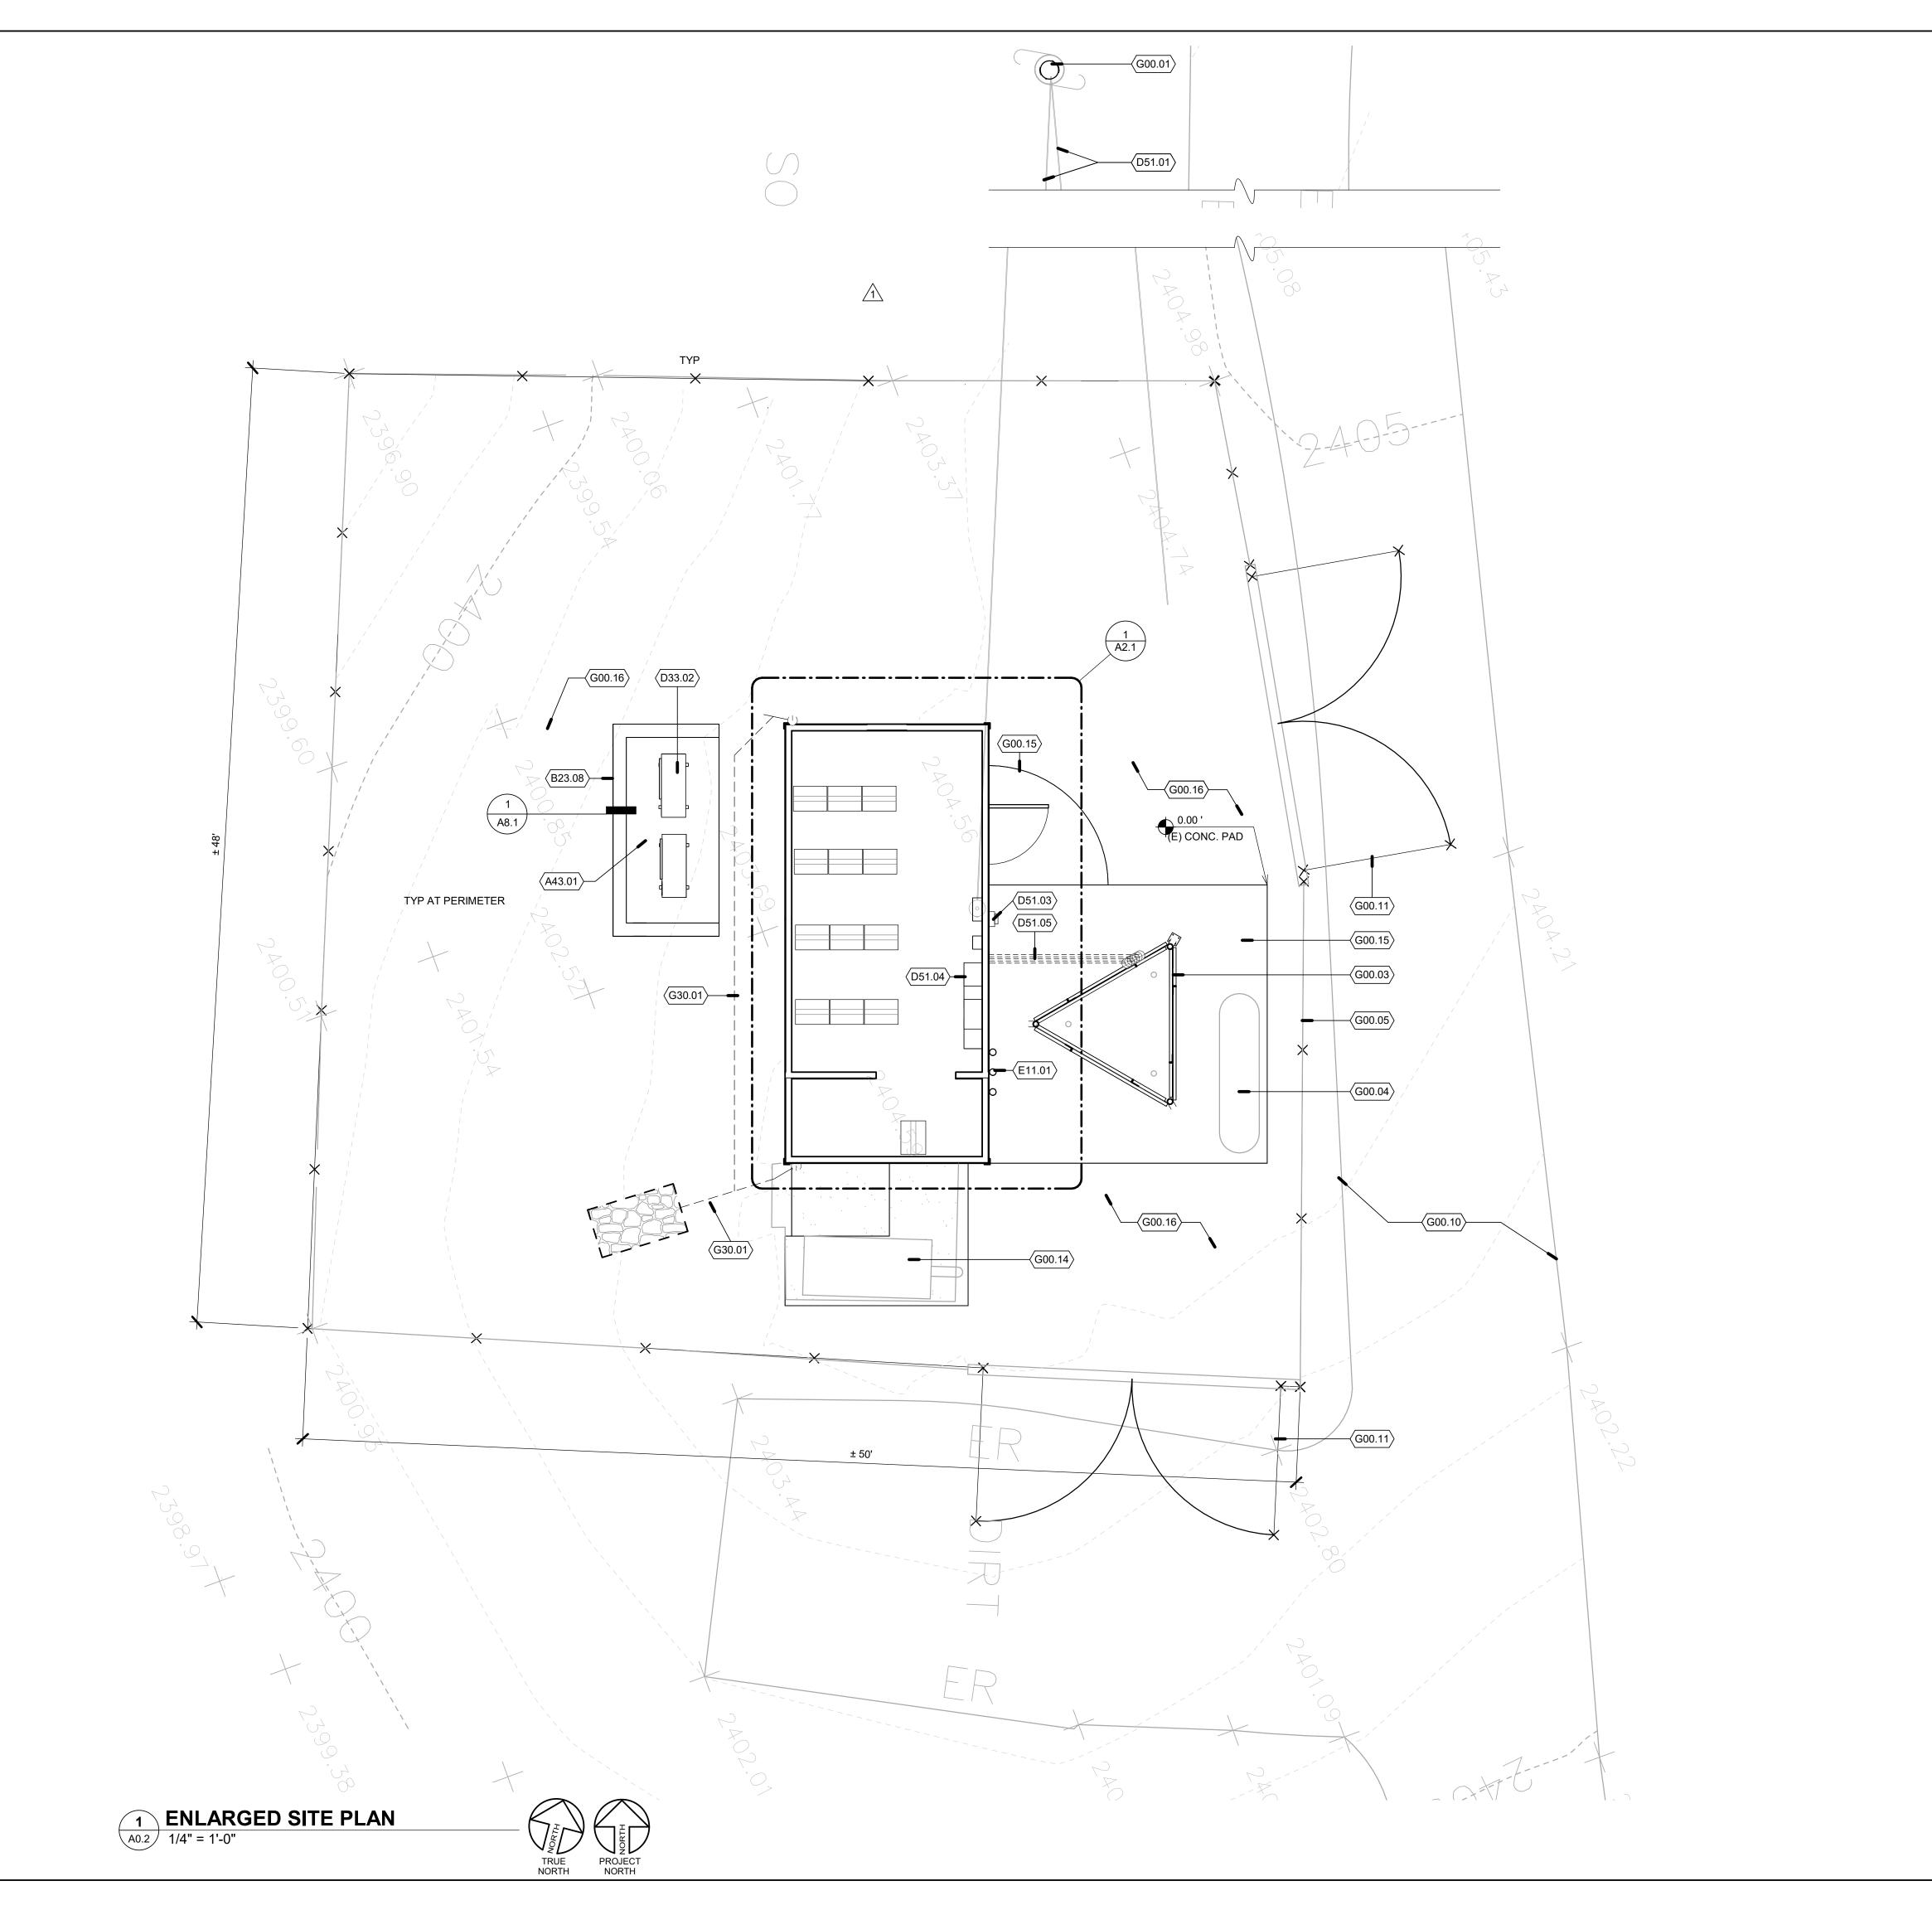

SITE PLAN GENERAL NOTES

- SCOPE DESCRIBED IS FOR COMPLETE PROJECT. CONTRACTOR SHALL REFER TO SHEET G2 AND COORDINATE WITH OWNER TO SEGMENT TIMING AND SEQUENCING OF WORK.
 - TOPOGRAPHIC AND REFERENCE LOCATIONS ARE BASED ON SITE SURVEY DATED "01/17/22" PREPARED BY: BKF ENGINEERS; 1646 N.
 - CALIFORNIA BLVD. SUITE 400 WALNUT CREEK, CA 94596 FINISHED FLOOR ELEVATIONS INDICATED ARE FOR BUILDING(S) ONLY. REFER TO CIVIL ENGINEERING DRAWINGS FOR ELEVATIONS RÉLATIVE

TO THE REST OF THE SITE AND FOR SITE FEATURES NOT OTHERWISE

- REFER TO MECHANICAL AND ELECTRICAL DRAWINGS FOR SITE FEATURES NOT OTHERWISE SHOWN.
- EXTERIOR CONCRETE FLATWORK: MAXIMUM SLOPE OF 1:20, UNO; EXTERIOR DOOR LANDINGS SHALL SLOPE 1/4" PER FOOT MAXIMUM FOR DRAINAGE. CONCRETE SHALL SLOPE MINIMUM 1/8" PER FOOT AWAY FROM BUILDINGS.
- NEATLY CUT AND REMOVE SURFACES AND FINISHES AS REQUIRED OR TO A NATURAL POINT OF DIVISION TO ENABLE INSTALLATION OF UTILITIES OR OTHER CONCEALED WORK, WHETHER SPECIFICALLY SHOWN OR INFERRED FOR SUPPORT OR RENOVATION. REFER TO CIVIL STRUCTURAL, MECHANICAL, PLUMBING, ELECTRICAL, AND LANDSCAPE DRAWINGS FOR CONCEALED WORK NOT SHOWN ON ARCHITECTURAL DRAWINGS.
- REPAIR AND REPLACE ALL EXISTING SURFACES AND FINISHES TO MATCH EXISTING UNDISTURBED WORK.
- FINAL GRADE: RAKE SMOOTH TO ONE-TENTH FOOT TOLERANCE. ALLOW FOR TOPSOIL PLACEMENT, IRRIGATION SLEEVE PLACEMENT AND LANDSCAPE PLANTING.
- EXCAVATIONS: BACKFILL AND COMPACT PROMPTLY AS WORK PROGRESSES. MINIMIZE OPEN TRENCHES.

EROSION CONTROL

INDICATED.

- PERFORM EROSION PREVENTION AND SEDIMENT CONTROL IN ACCORDANCE WITH THE LATEST EDITION OF APPENDIX CHAPTER 33 OF THE CALIFORNIA BUILDING CODE, APPLICABLE SONOMA COUNTY REGULATIONS, AND SECTION 20 OF THE CALTRANS STANDARD SPECIFICATIONS.
- THE APPROVED PLANS SHALL CONFORM WITH THE EROSION PREVENTION AND SEDIMENT CONTROL BEST MANAGEMENT PRACTICES CONTAINED IN THE LATEST EDITIONS OF THE FOLLOWING PUBLICATIONS OR AN EQUIVALENT BEST MANAGEMENT PRACTICE: A. EROSION AND SEDIMENT CONTROL FIELD MANUAL BY THE SAN FRANCISCO BAY REGIONAL WATER QUALITY CONTROL BOARD.
 - MANUAL OF STANDARDS FOR EROSION & SEDIMENT CONTROL MEASURES BY THE ASSOCIATION OF BAY AREA GOVERNMENTS.
- STORMWATER BEST MANAGEMENT PRACTICE HANDBOOK BY THE CALIFORNIA STORMWATER QUALITY ASSOCIATION.
- IF DISCREPANCIES OCCUR BETWEEN THESE NOTES, MATERIAL REFERENCED HEREIN OR MANUFACTURER'S RECOMMENDATIONS, THEN THE MOST PROTECTIVE SHALL APPLY.
- THE OWNER IS RESPONSIBLE FOR PREVENTING STORM WATER POLLUTION GENERATED FROM THE CONSTRUCTION SITE YEAR-ROUND. THE OWNER MUST IMPLEMENT AN EFFECTIVE COMBINATION OF EROSION PREVENTION AND SEDIMENT CONTROL ON ALL DISTURBED AREAS DURING THE RAINY SEASON (OCTOBER 15 - APRIL
- CHANGES TO THE EROSION PREVENTION AND SEDIMENT CONTROL PLAN MAY BE MADE TO RESPOND TO FIELD CONDITIONS. CHANGES SHALL BE NOTED ON THE PLAN WHEN MADE.
- EXPOSED SLOPES SHALL BE PROTECTED BY USING EROSION PREVENTION MEASURES TO THE MAXIMUM EXTENT PRACTICABLE, SUCH AS ESTABLISHING 70% VEGETATION COVERAGE, HYDROSEEDING, STRAW MULCH, GEOTEXTILES, PLASTIC COVERS, BLANKETS OR MATS.
- WHENEVER IT IS NOT POSSIBLE TO UTILIZE EROSION PREVENTION MEASURES, EXPOSED SLOPE SHALL EMPLOY SEDIMENT CONTROL DEVICES, SUCH AS FIBER ROLLS AND SILT FENCES. FIBER ROLLS AND SILT FENCES SHALL BE TRENCHED AND KEYED INTO THE SOIL AND INSTALLED ON CONTOUR. SILT FENCES SHALL BE INSTALLED APPROXIMATELY 2 TO 5 FEET FROM THE TOE OF SLOPE.
- ENERGY DISSIPATERS SHALL BE INSTALLED AT STORM DRAIN OUTLETS | 👸 WHICH MAY CONVEY STORM WATER FLOW LEADING TO SOIL EROSION.
- SOIL AND MATERIAL STOCKPILES SHALL BE PROPERLY PROTECTED TO MINIMIZE SEDIMENT AND POLLUTANT TRANSPORT FROM THE CONSTRUCTION SITE.
- SOLID WASTE, SUCH AS TRASH, DISCARDED BUILDING MATERIALS AND DEBRIS, SHALL BE PLACED IN DESIGNATED COLLECTION AREAS OR CONTAINERS. THE CONSTRUCTION SITE SHALL BE CLEARED OF SOLID WASTE DAILY, OR NECESSARY AND REGULAR REMOVAL AND PROPER DISPOSAL SHALL BE ARRANGED.

KEYNOTES

A43.01 B23.08

D33.02 D51.01

D51.03

D51.04

D51.05 E11.01

G00.01

G00.03

G00.04

G00.05

G00.10 G00.11 G00.14 G00.15 G00.16 G30.01

INC THOTES	J
CONCRETE SLAB, SSD	
(N) CMU WALL AT HEAT-PUMP SLAB	
INSTALL GROUND-MOUNTED HEAT PUMP UNIT, SMD	REV :
(E) OVERHEAD POWER LINE TO REMAIN. COORDINATE POWER SHUTDOWN WITH OWNER. PROTECT DURING CONSTRUCTION.	1
(E) ELECTRICAL SERVICE METER AND SERVICE DROP ABOVE. PROTECT DURING CONSTRUCTION.	
(E) WALL MOUNTED GENERATOR ATS, TO REMAIN. PROTECT DURING CONSTRUCTION; TYP.	
(E) TELECOM AND DATA CABLING TO BE REMAIN	
(E) EQUIPMENT MASTS AND SENSORS SURFACE MOUNTED TO (E) VAULT EXTERIOR WALL. PROTECT DURING CONSTRUCTION	
(E) PG&E POWER POLE WITH POLE MOUNTED TRANSFORMER, TO REMAIN	
(E) 60'± TALL ANTENNA ON EXISTING STRUCTURAL CONCRETE PAD, TO REMAIN	
(E) PROPANE TANK SEISMICALLY ANCHORED TO EXISTING STRUCTURAL CONCRETE PAD, TO REMAIN	
(E) 6' CHAIN LINK FENCE, EXTENT OF LEASED PROPERTY BY COUNTY, TO REMAIN	
APPROXIMATE EDGE OF (E) DIRT DRIVEWAY, ± 10' WIDE	
(E) CHAIN LINK SWING GATE, TO REMAIN	
(E) GENERATOR ON CONCRETE PAD, TO REMAIN	
(E) CONCRETE SLAB, TO REMAIN, TYP UNO	
(E) COMPACT EXPOSED EARTH, TYPICAL U.N.O	
NEW 3" DIAMETER HDPE STORM DRAINAGE LINE SET 18" BELOW	
GRADE SLOPED TO OUTLET AT RIP RAP. BACKFILL TRENCH WITH SOIL - PEA GRAVEL TO 95% COMPACTION.	
WITH GOIL - I LA GIVAVEL 10 90/0 GOIVII ACTION.	


SHEET LOG 09/19/24 ADDENDUM 0

JOB NUMBER:

A0.2 ENLARGED SITE PLAN

ORIGINAL DATE:

© AXIA ARCHITECTS

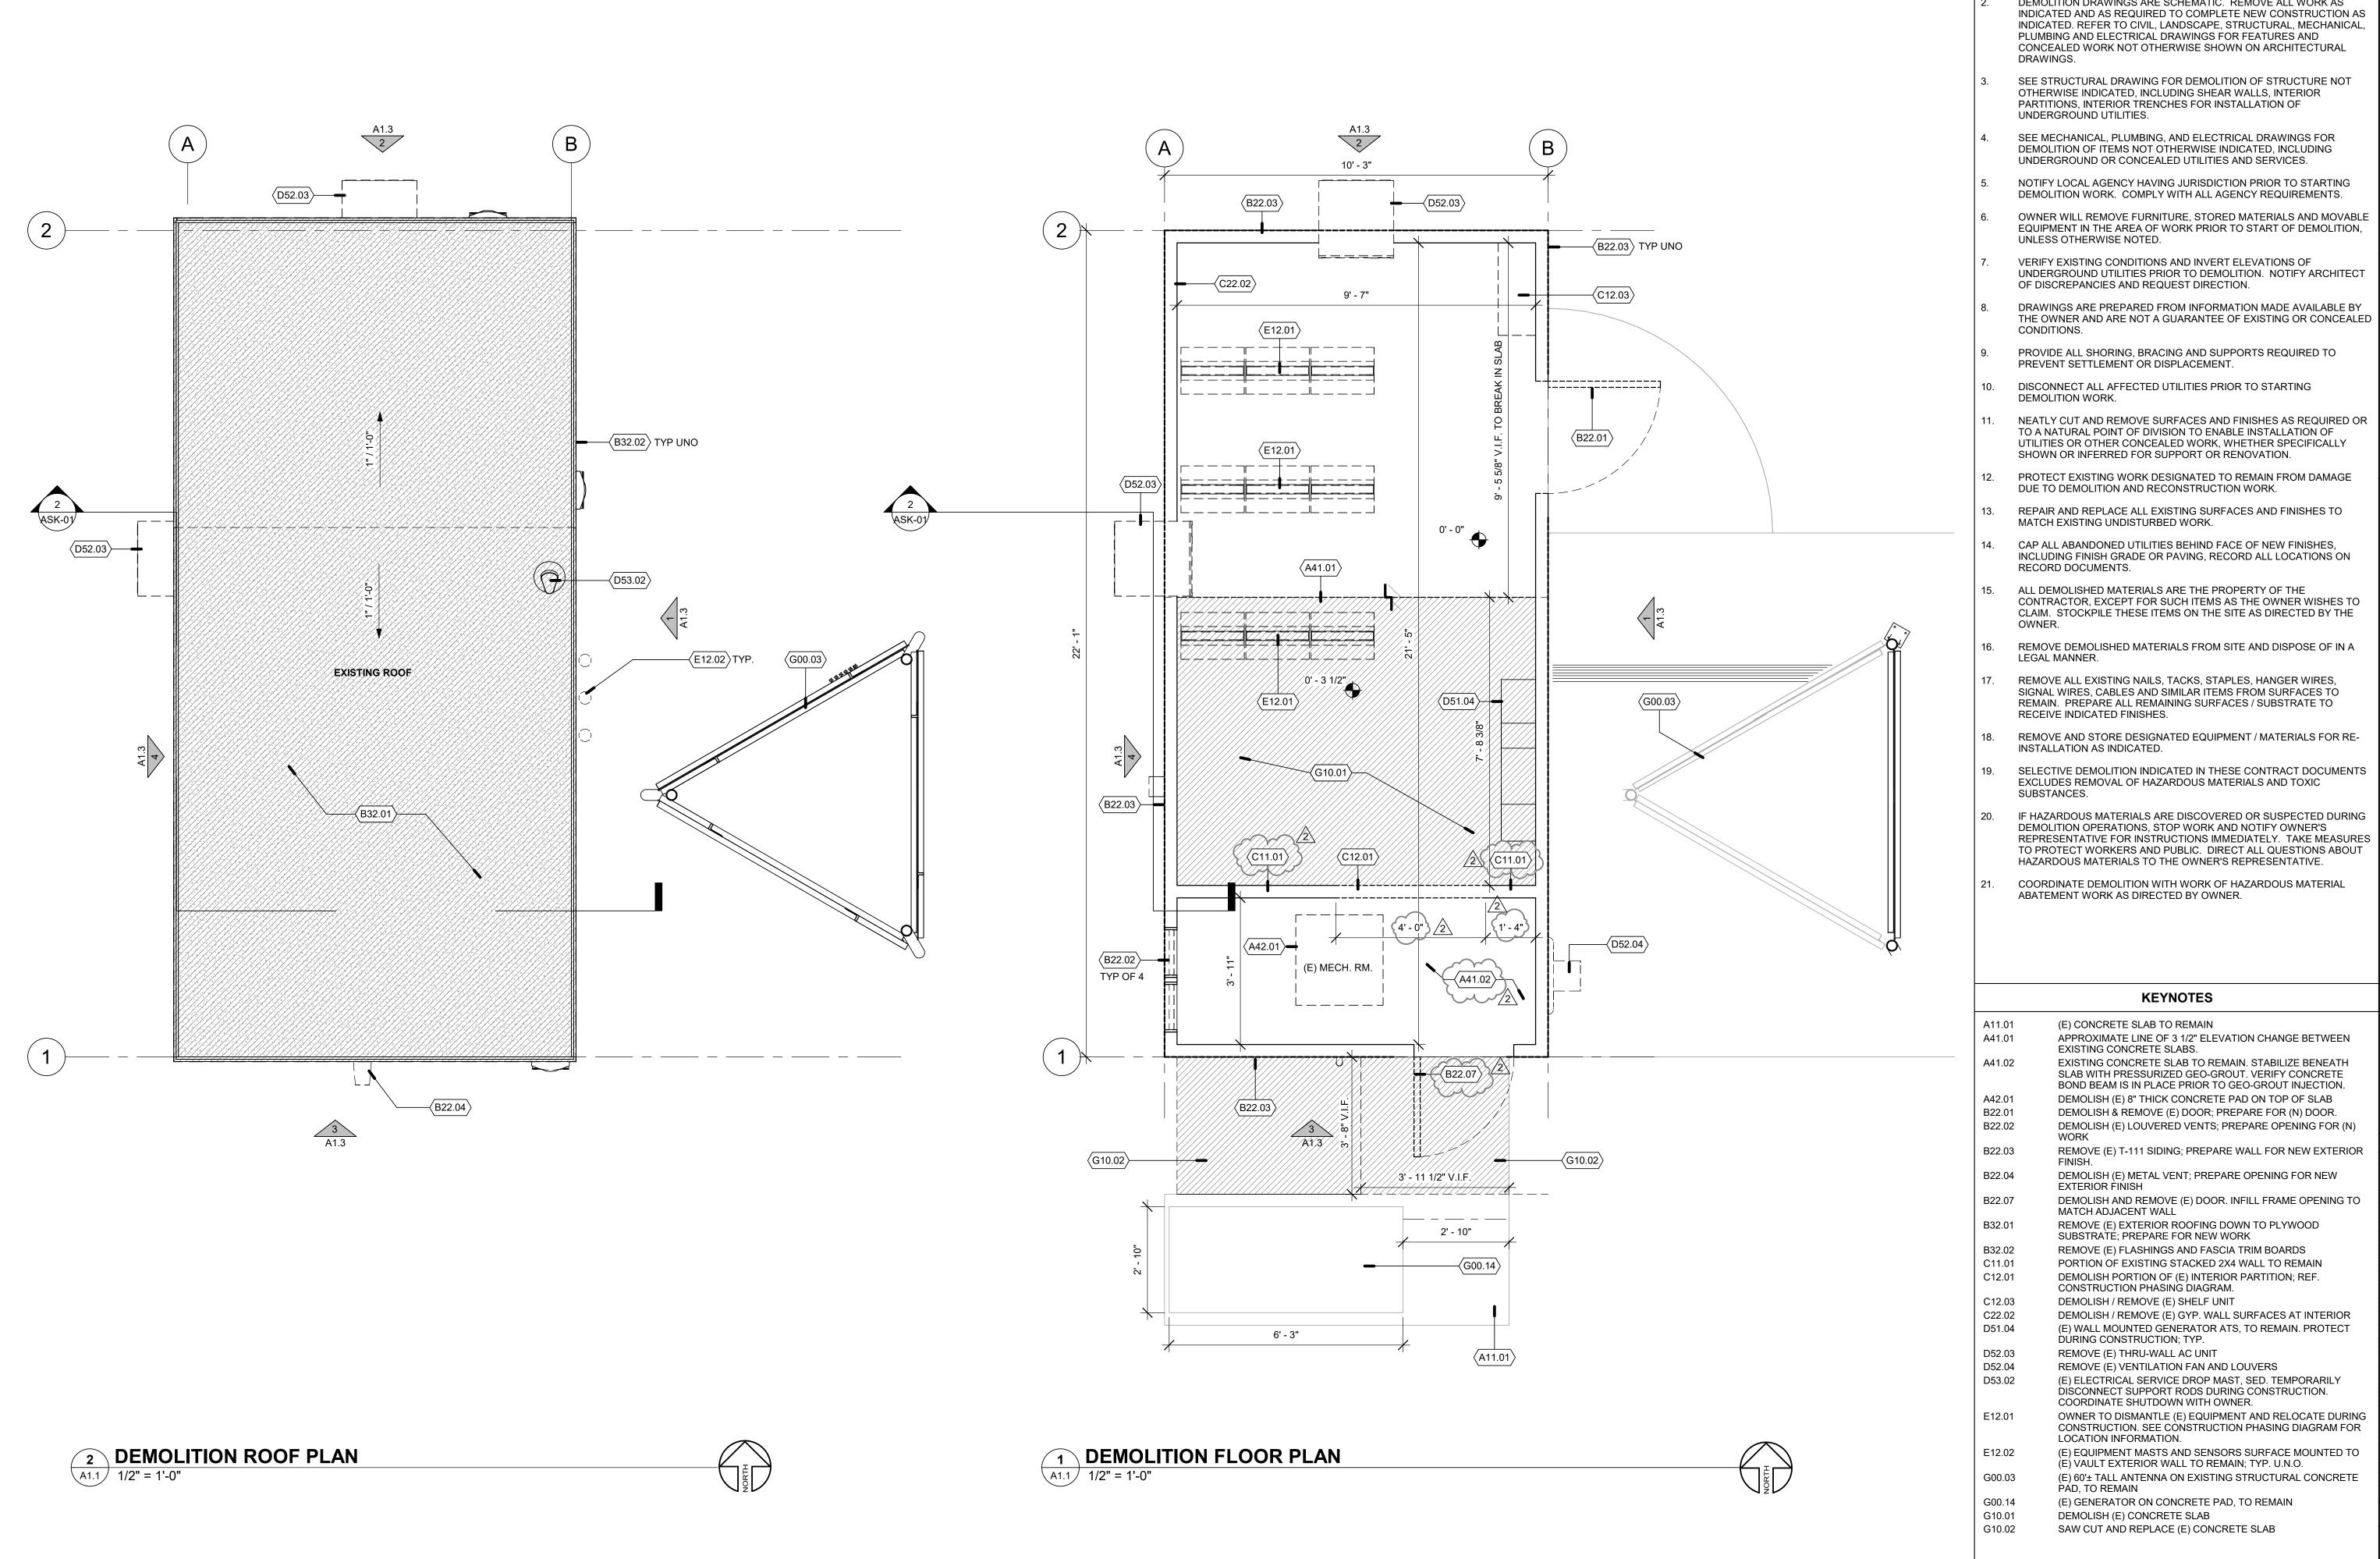

SCOPE DESCRIBED IS FOR COMPLETE PROJECT. CONTRACTOR SHALL REFER TO SHEET G2 AND COORDINATE WITH OWNER TO SEGMENT TIMING AND SEQUENCING OF WORK.

DEMOLITION DRAWINGS ARE SCHEMATIC. REMOVE ALL WORK AS

GENERAL DEMOLITION NOTES


PINE


SHEET LOG ISSUED FOR: 3/24/25 PERMIT RESUBMITTAL


JOB NUMBER:


EXISTING / DEMOLITION FLOOR PLAN & ROOF PLAN


ORIGINAL DATE: © AXIA ARCHITECTS

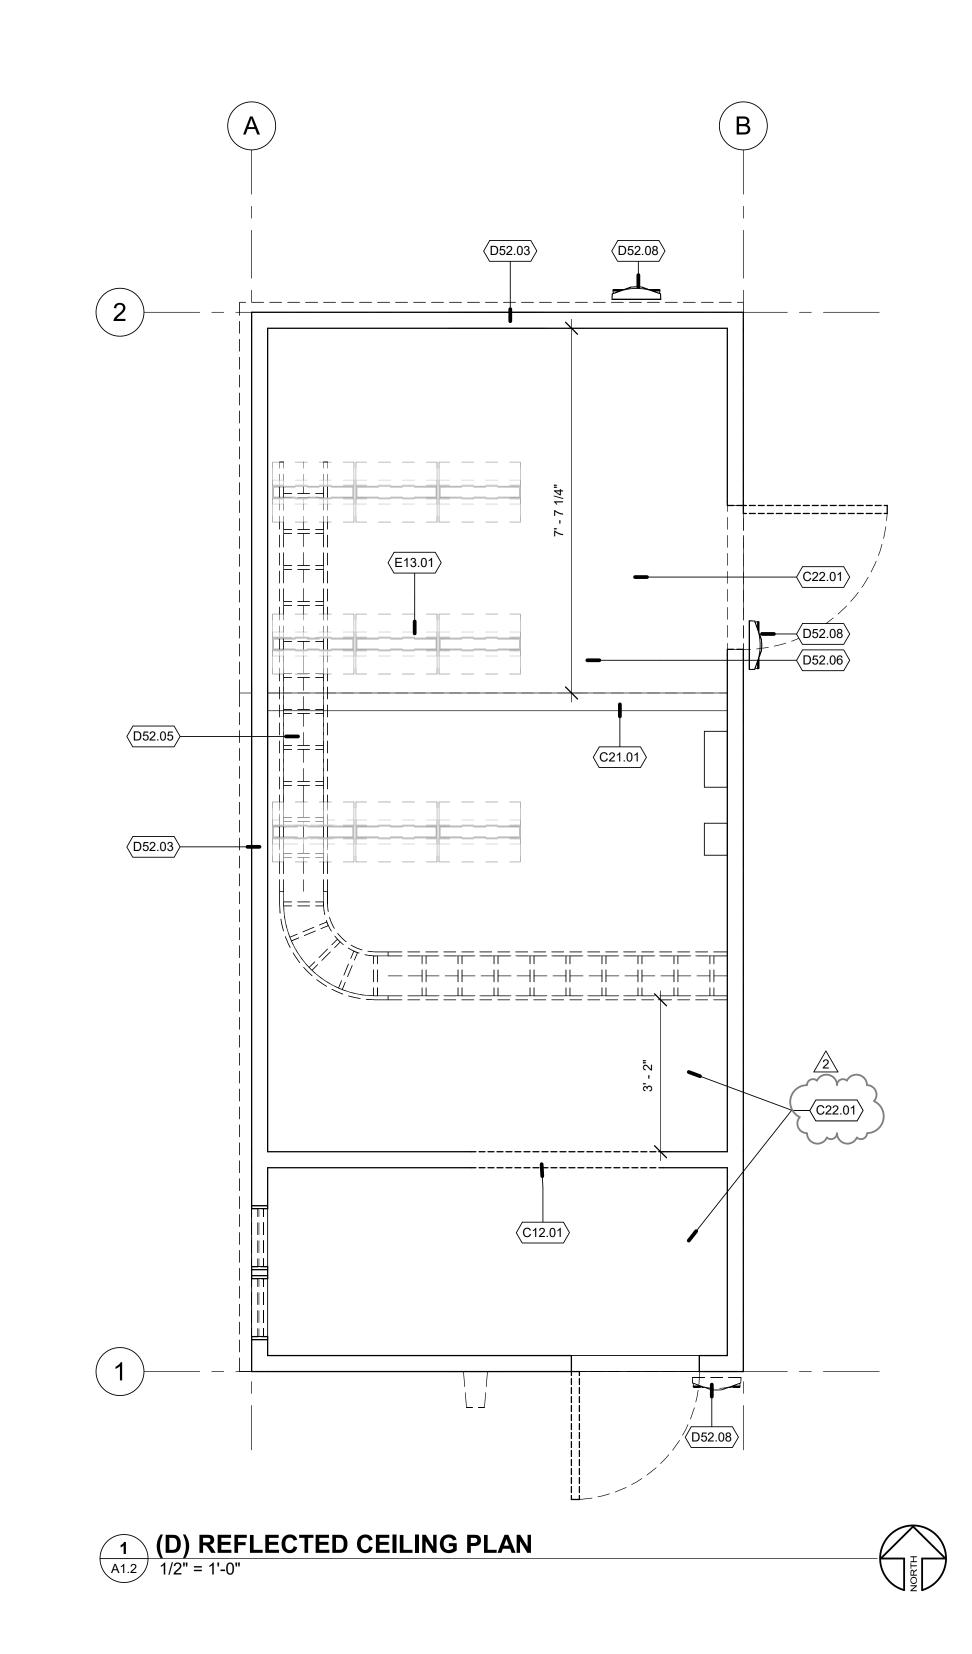

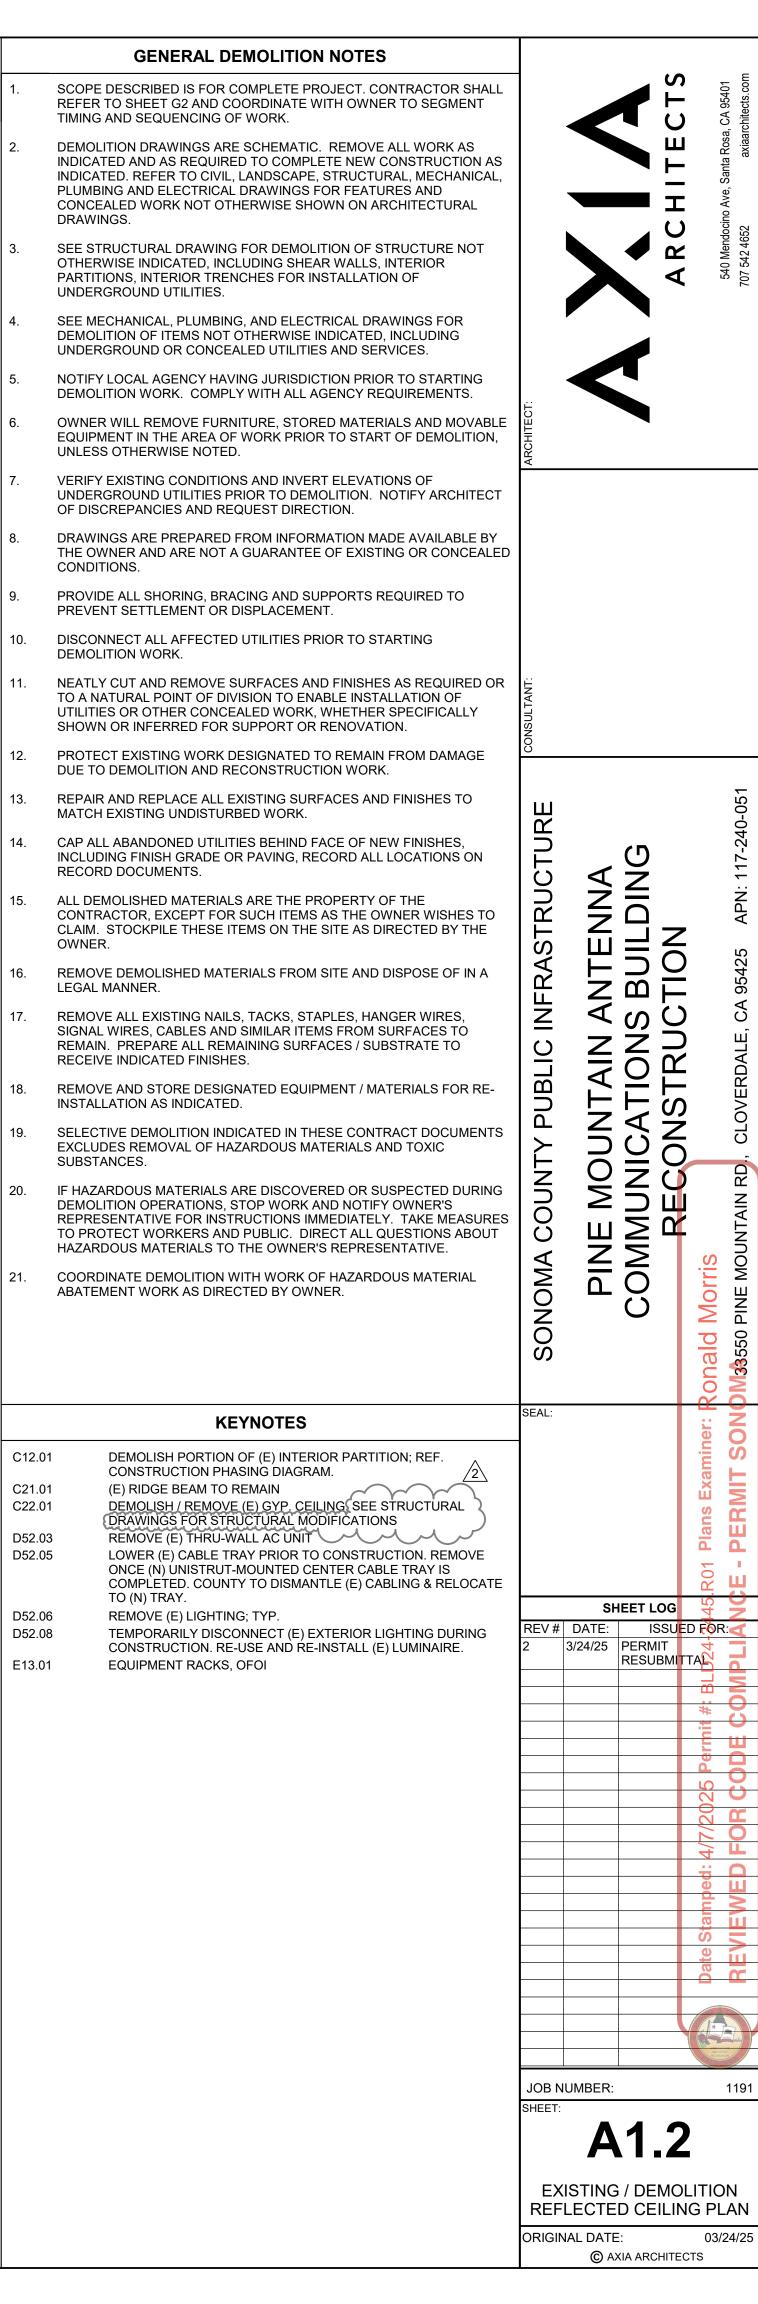


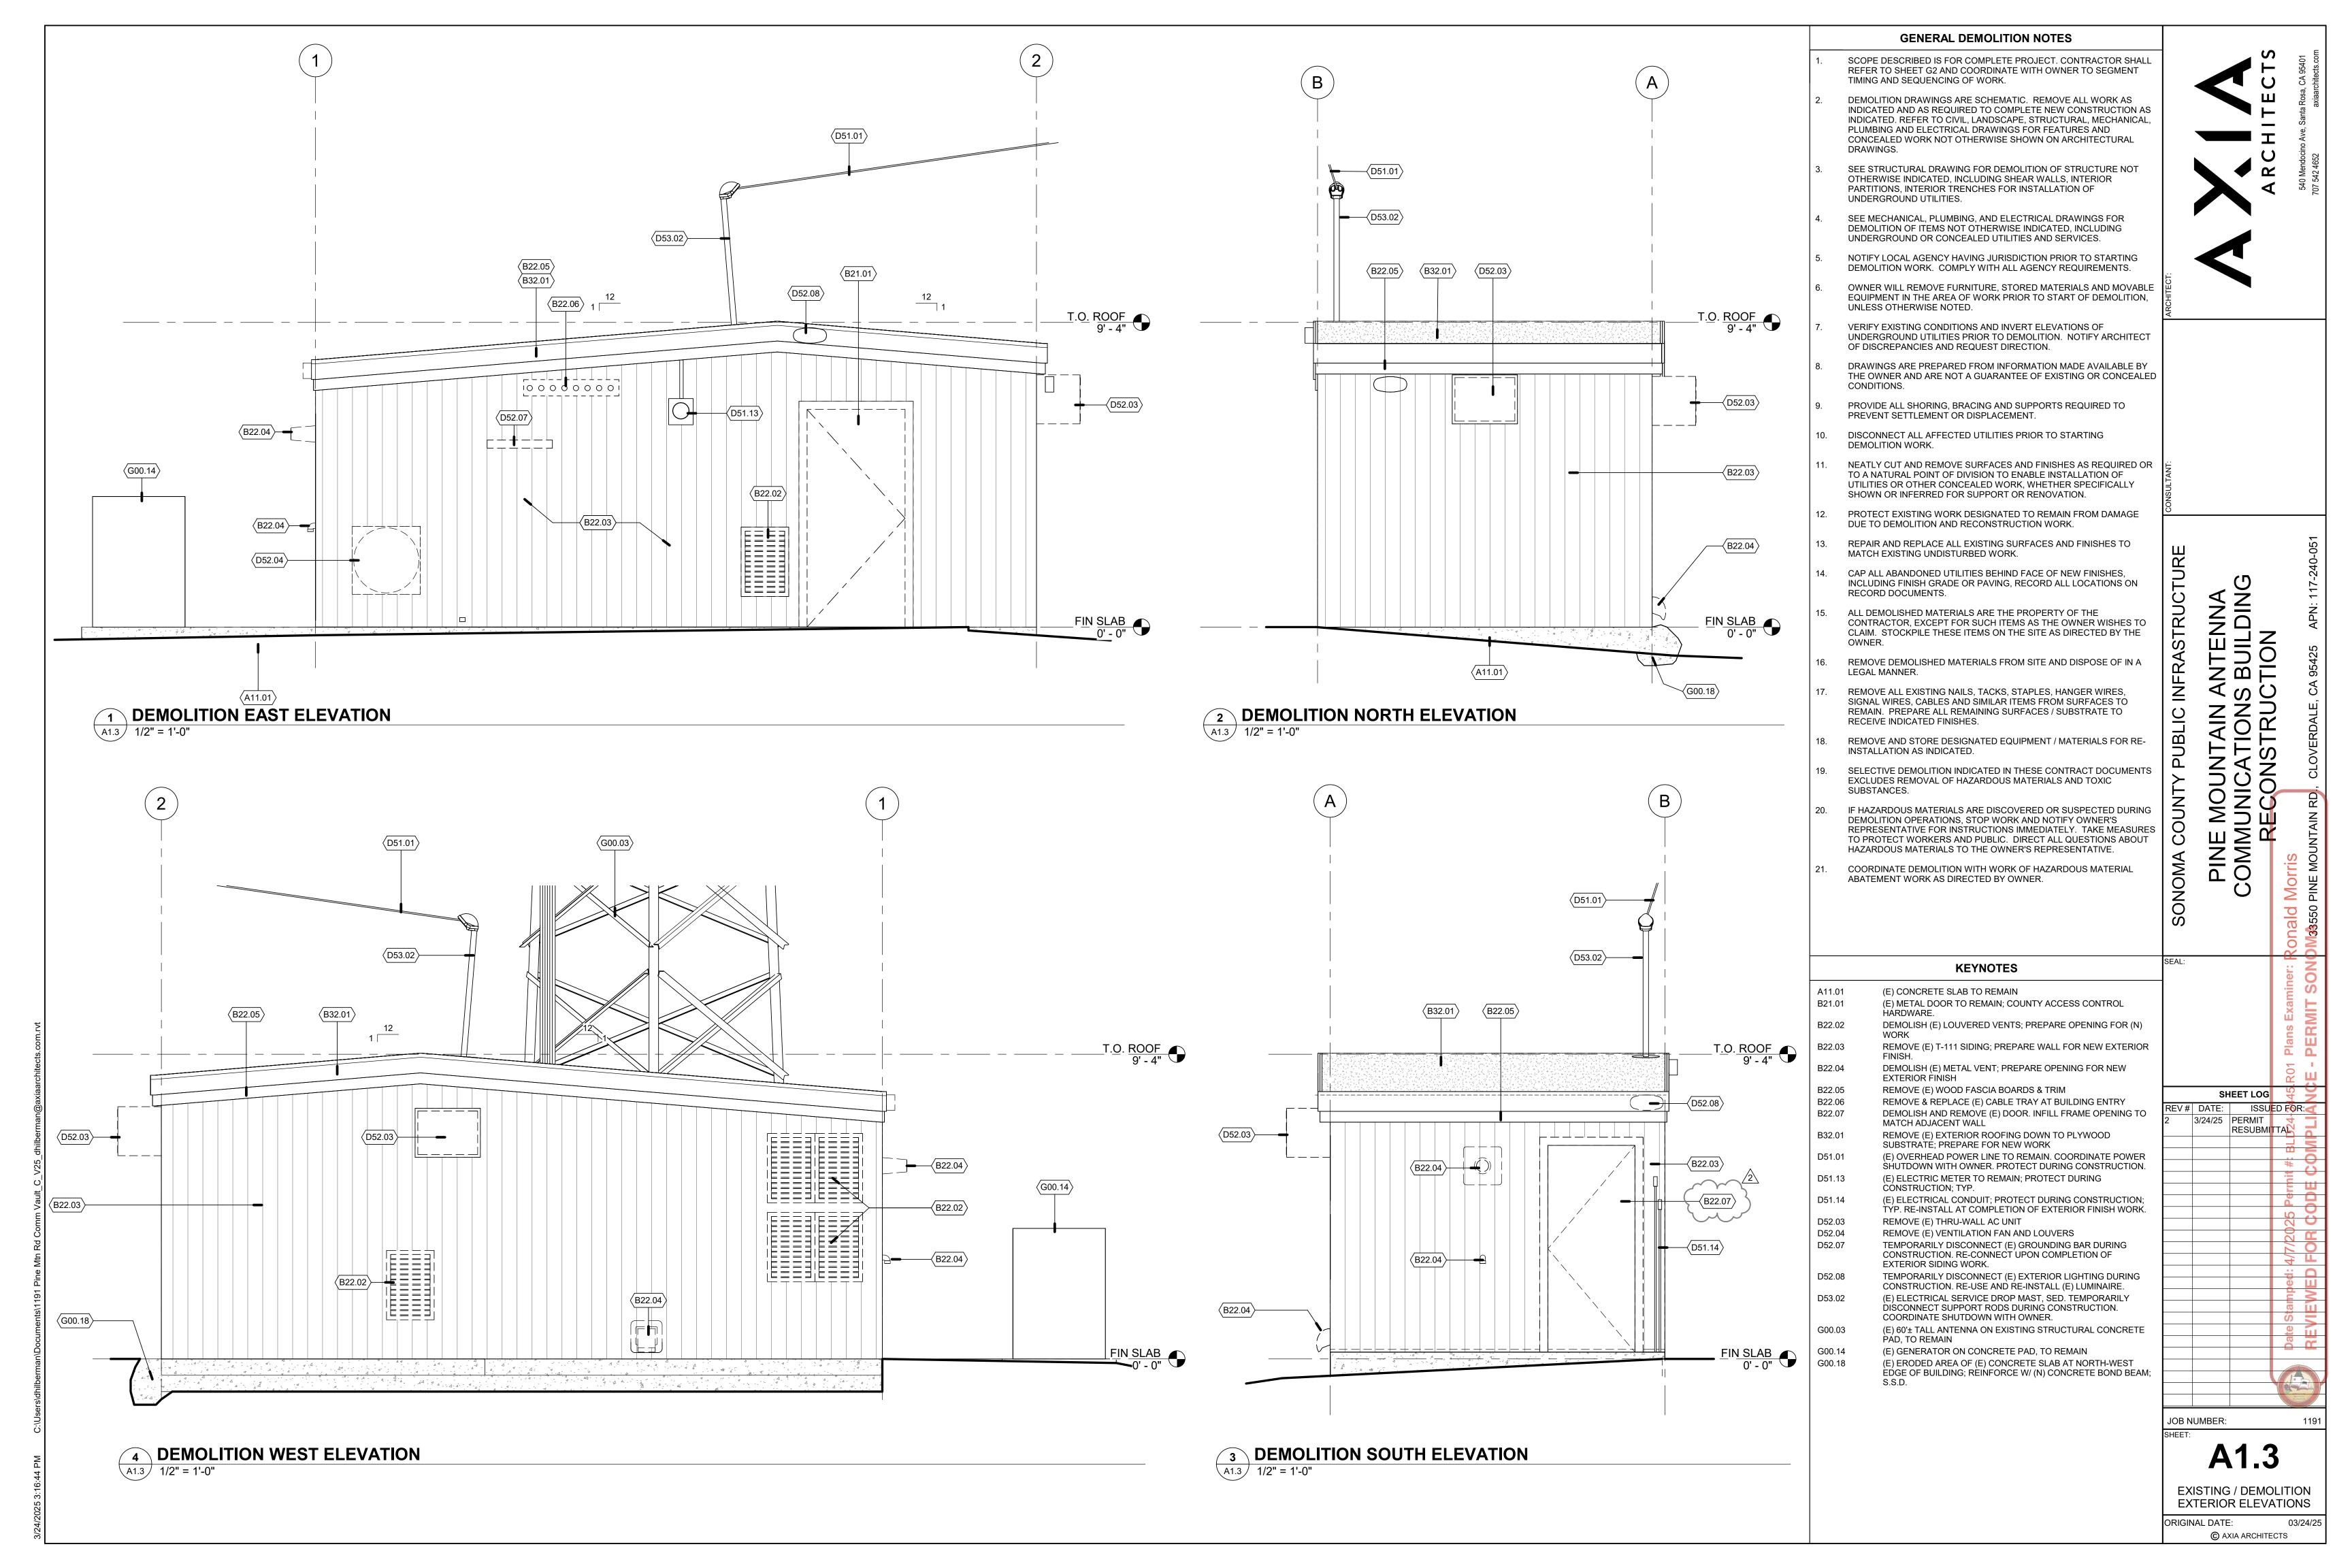

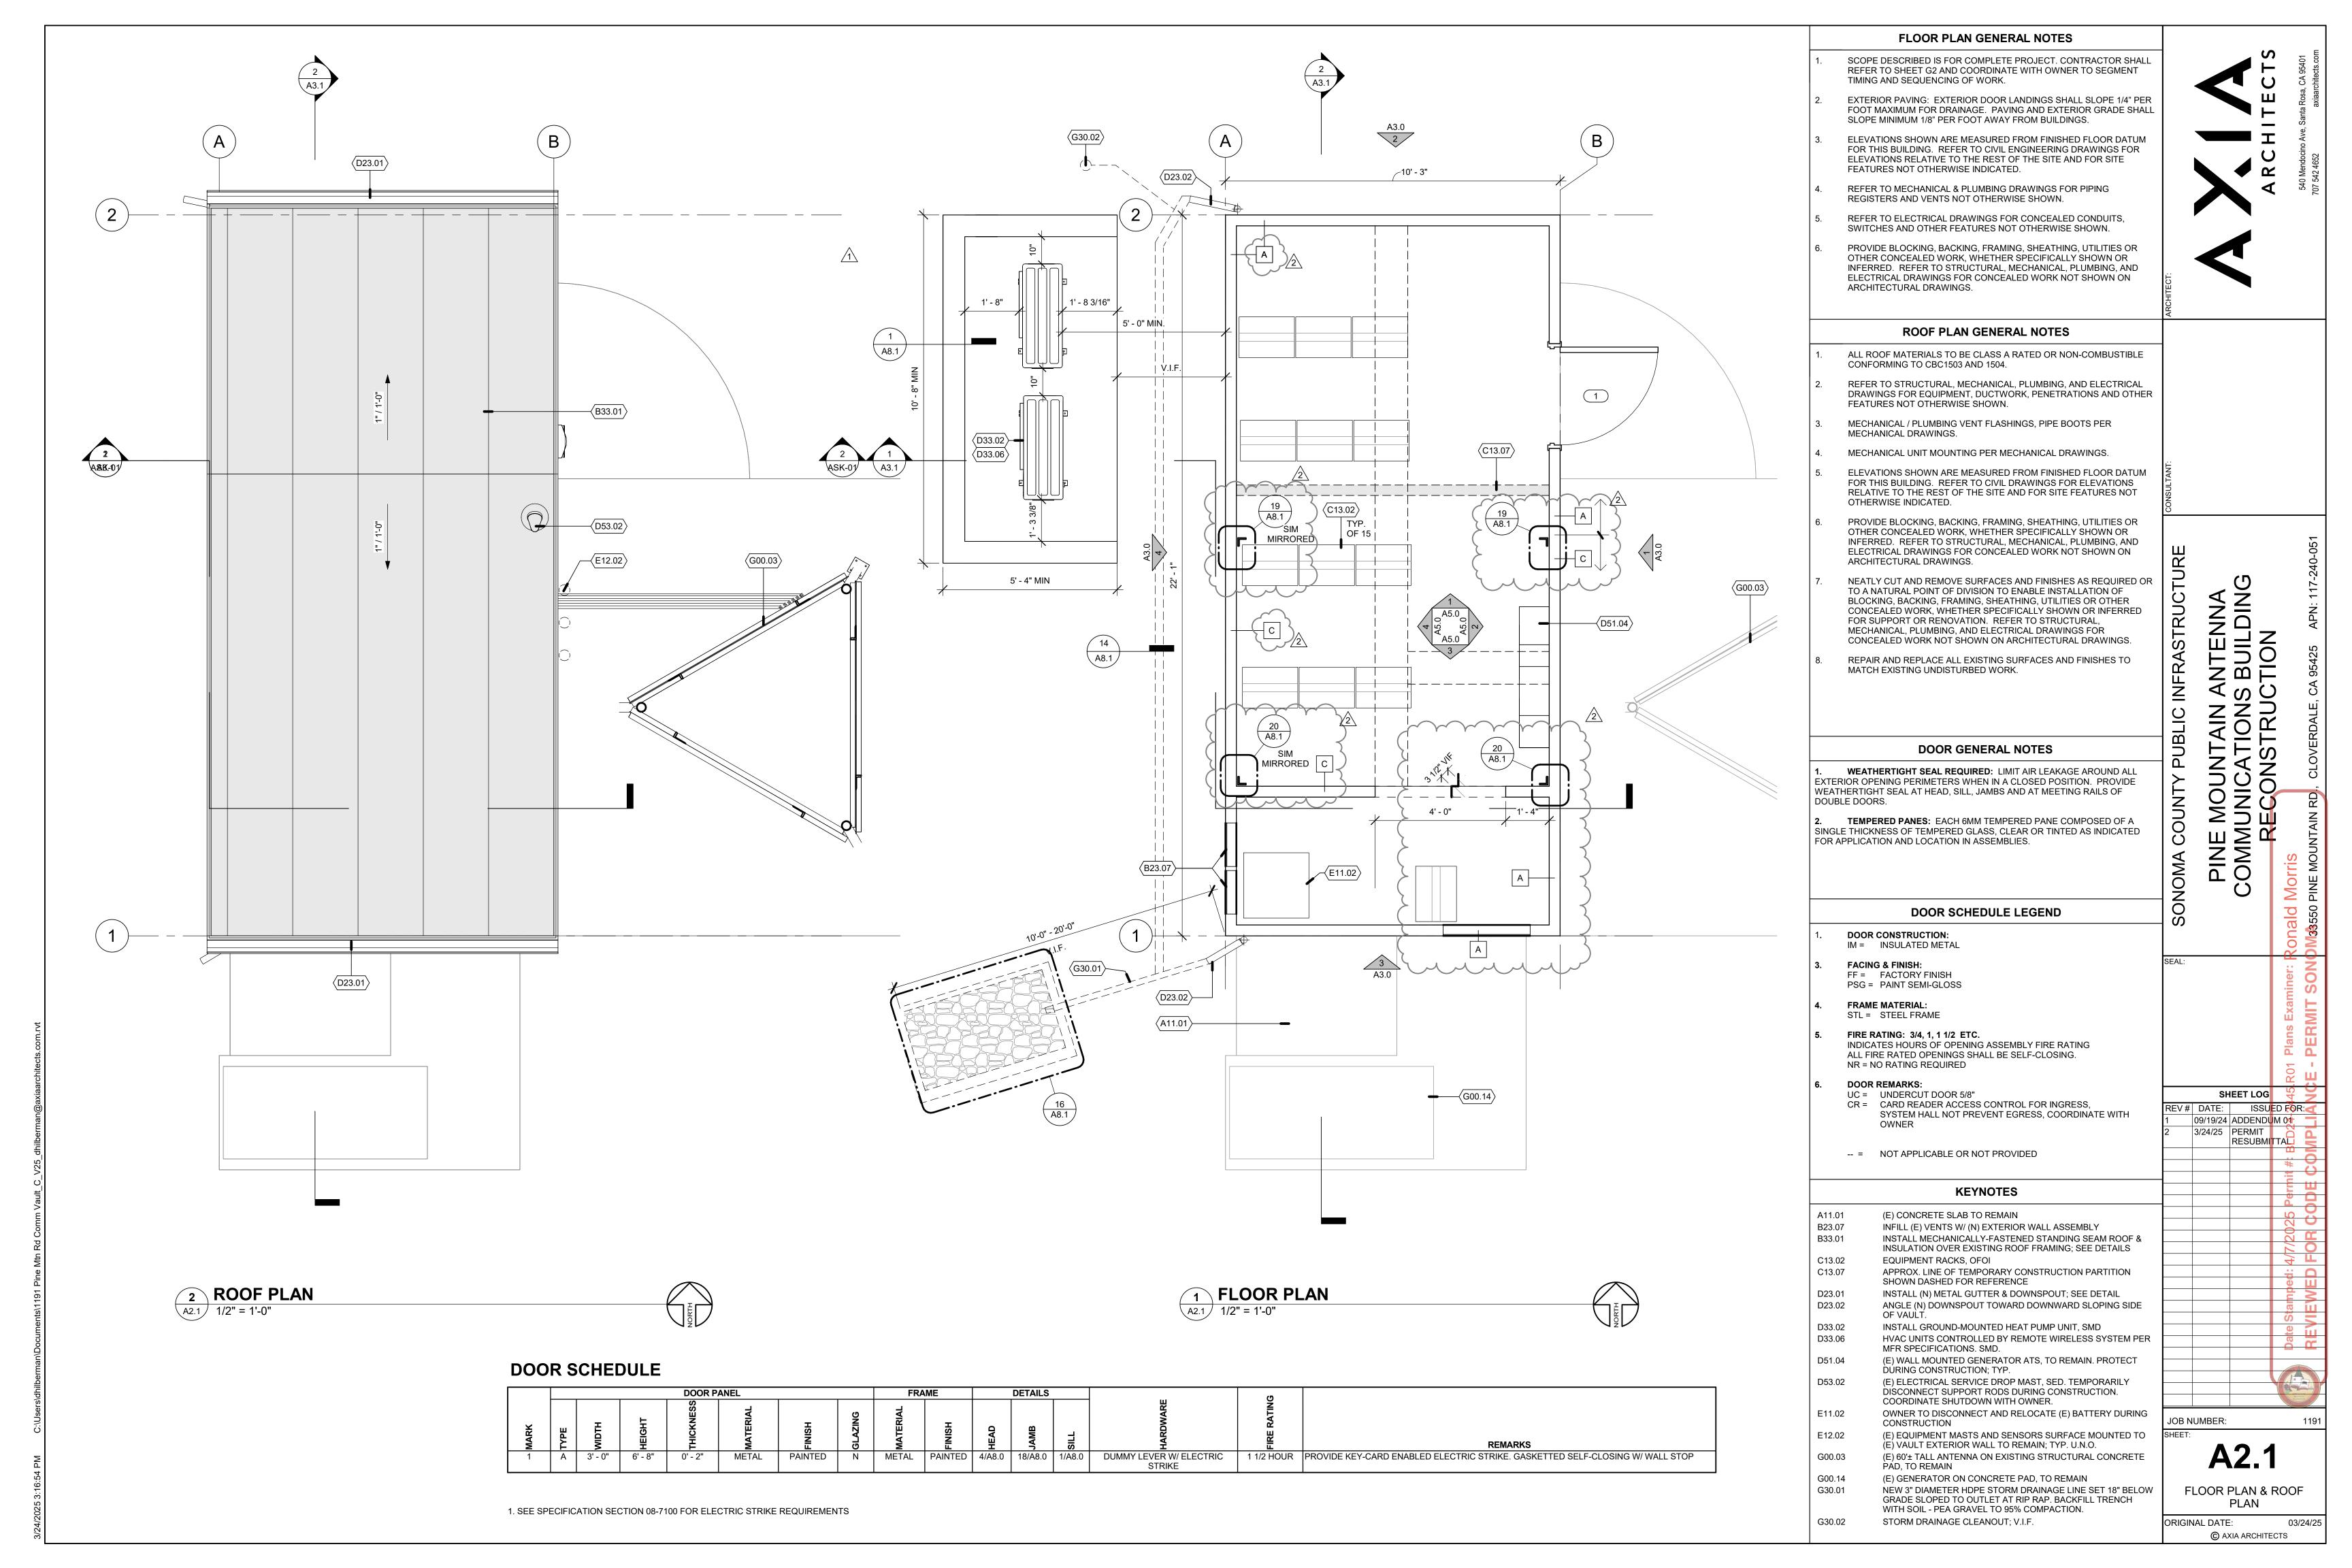


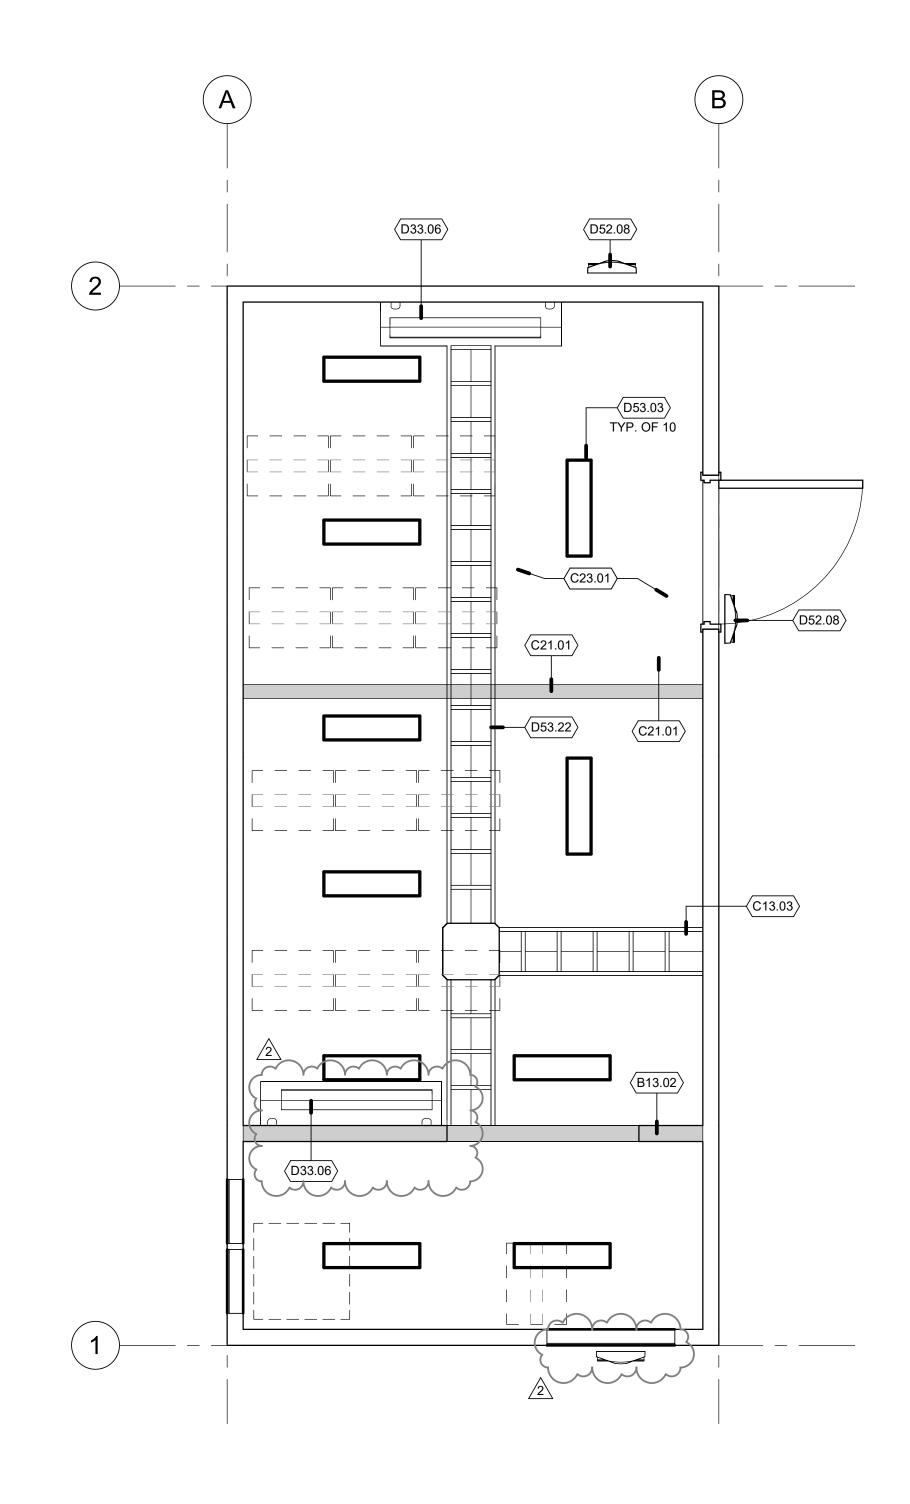



(N) REFLECTED CEILING PLAN
A2.2 1/2" = 1'-0"

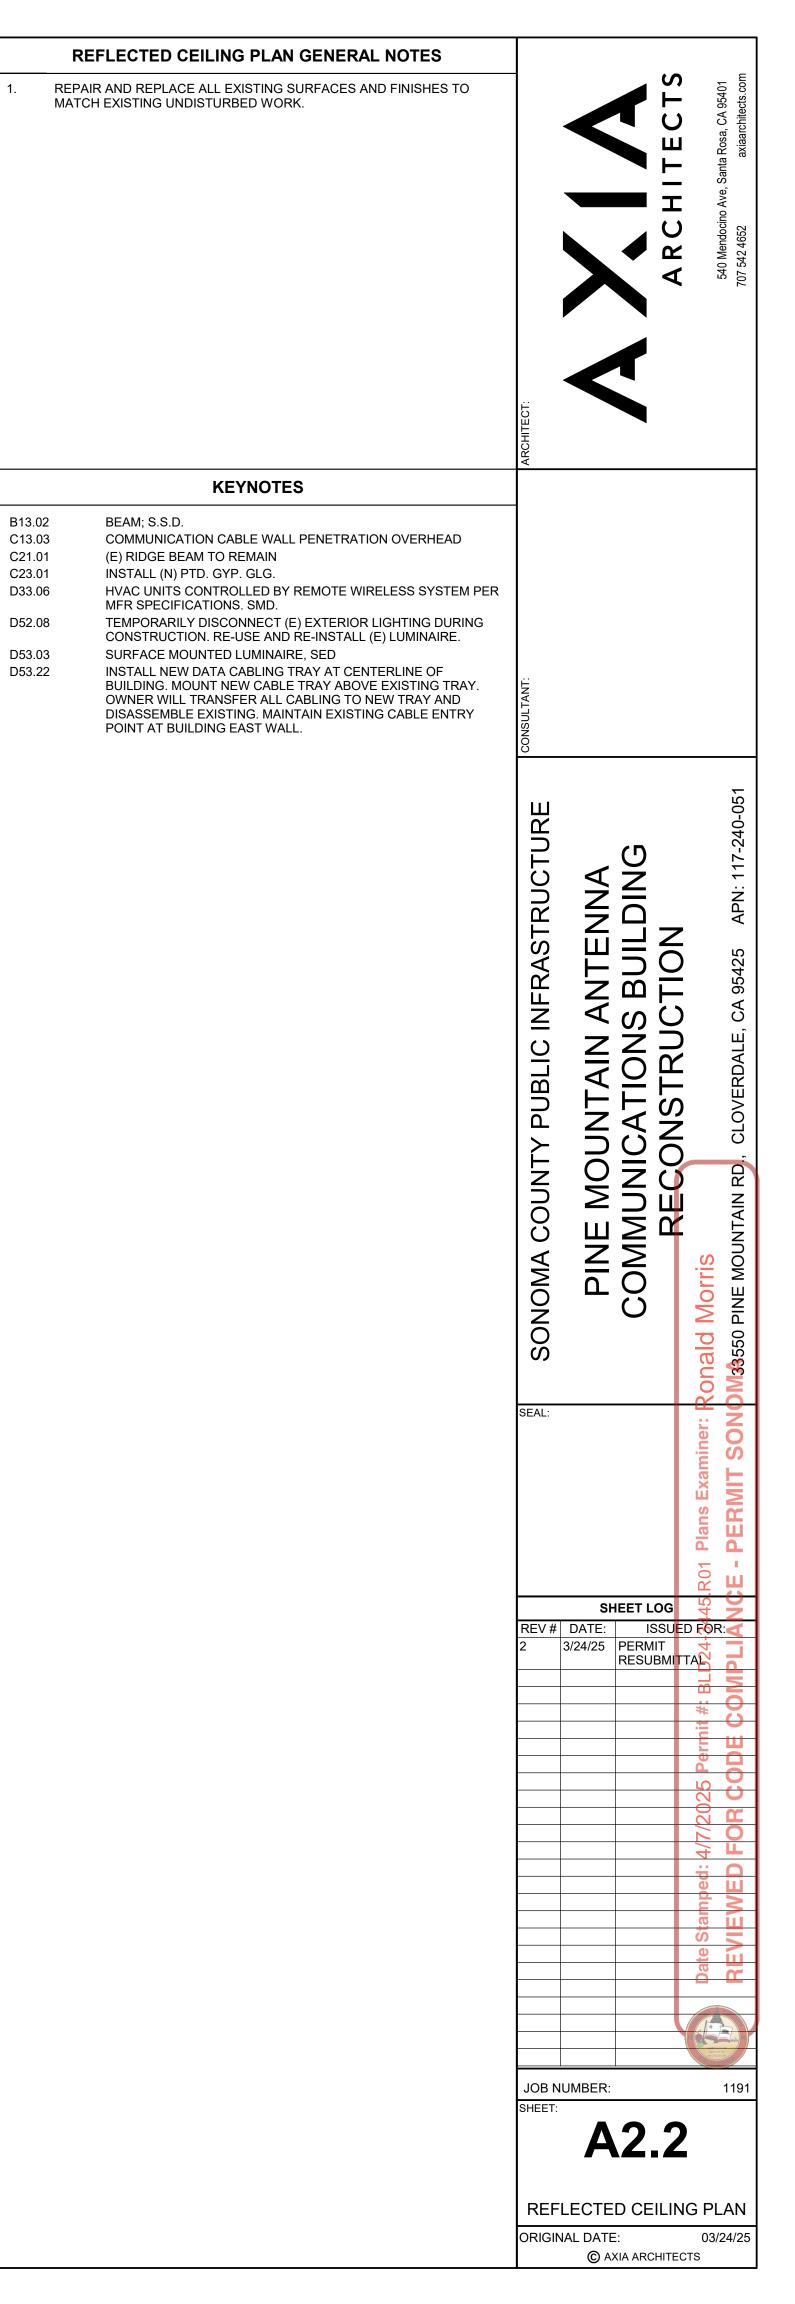


25 3:17:03 PM C:\Users\dhilberman\Documents\1191 Pine Mtn Rd Comm Vault_C_V25_dhilberman@axiaarch

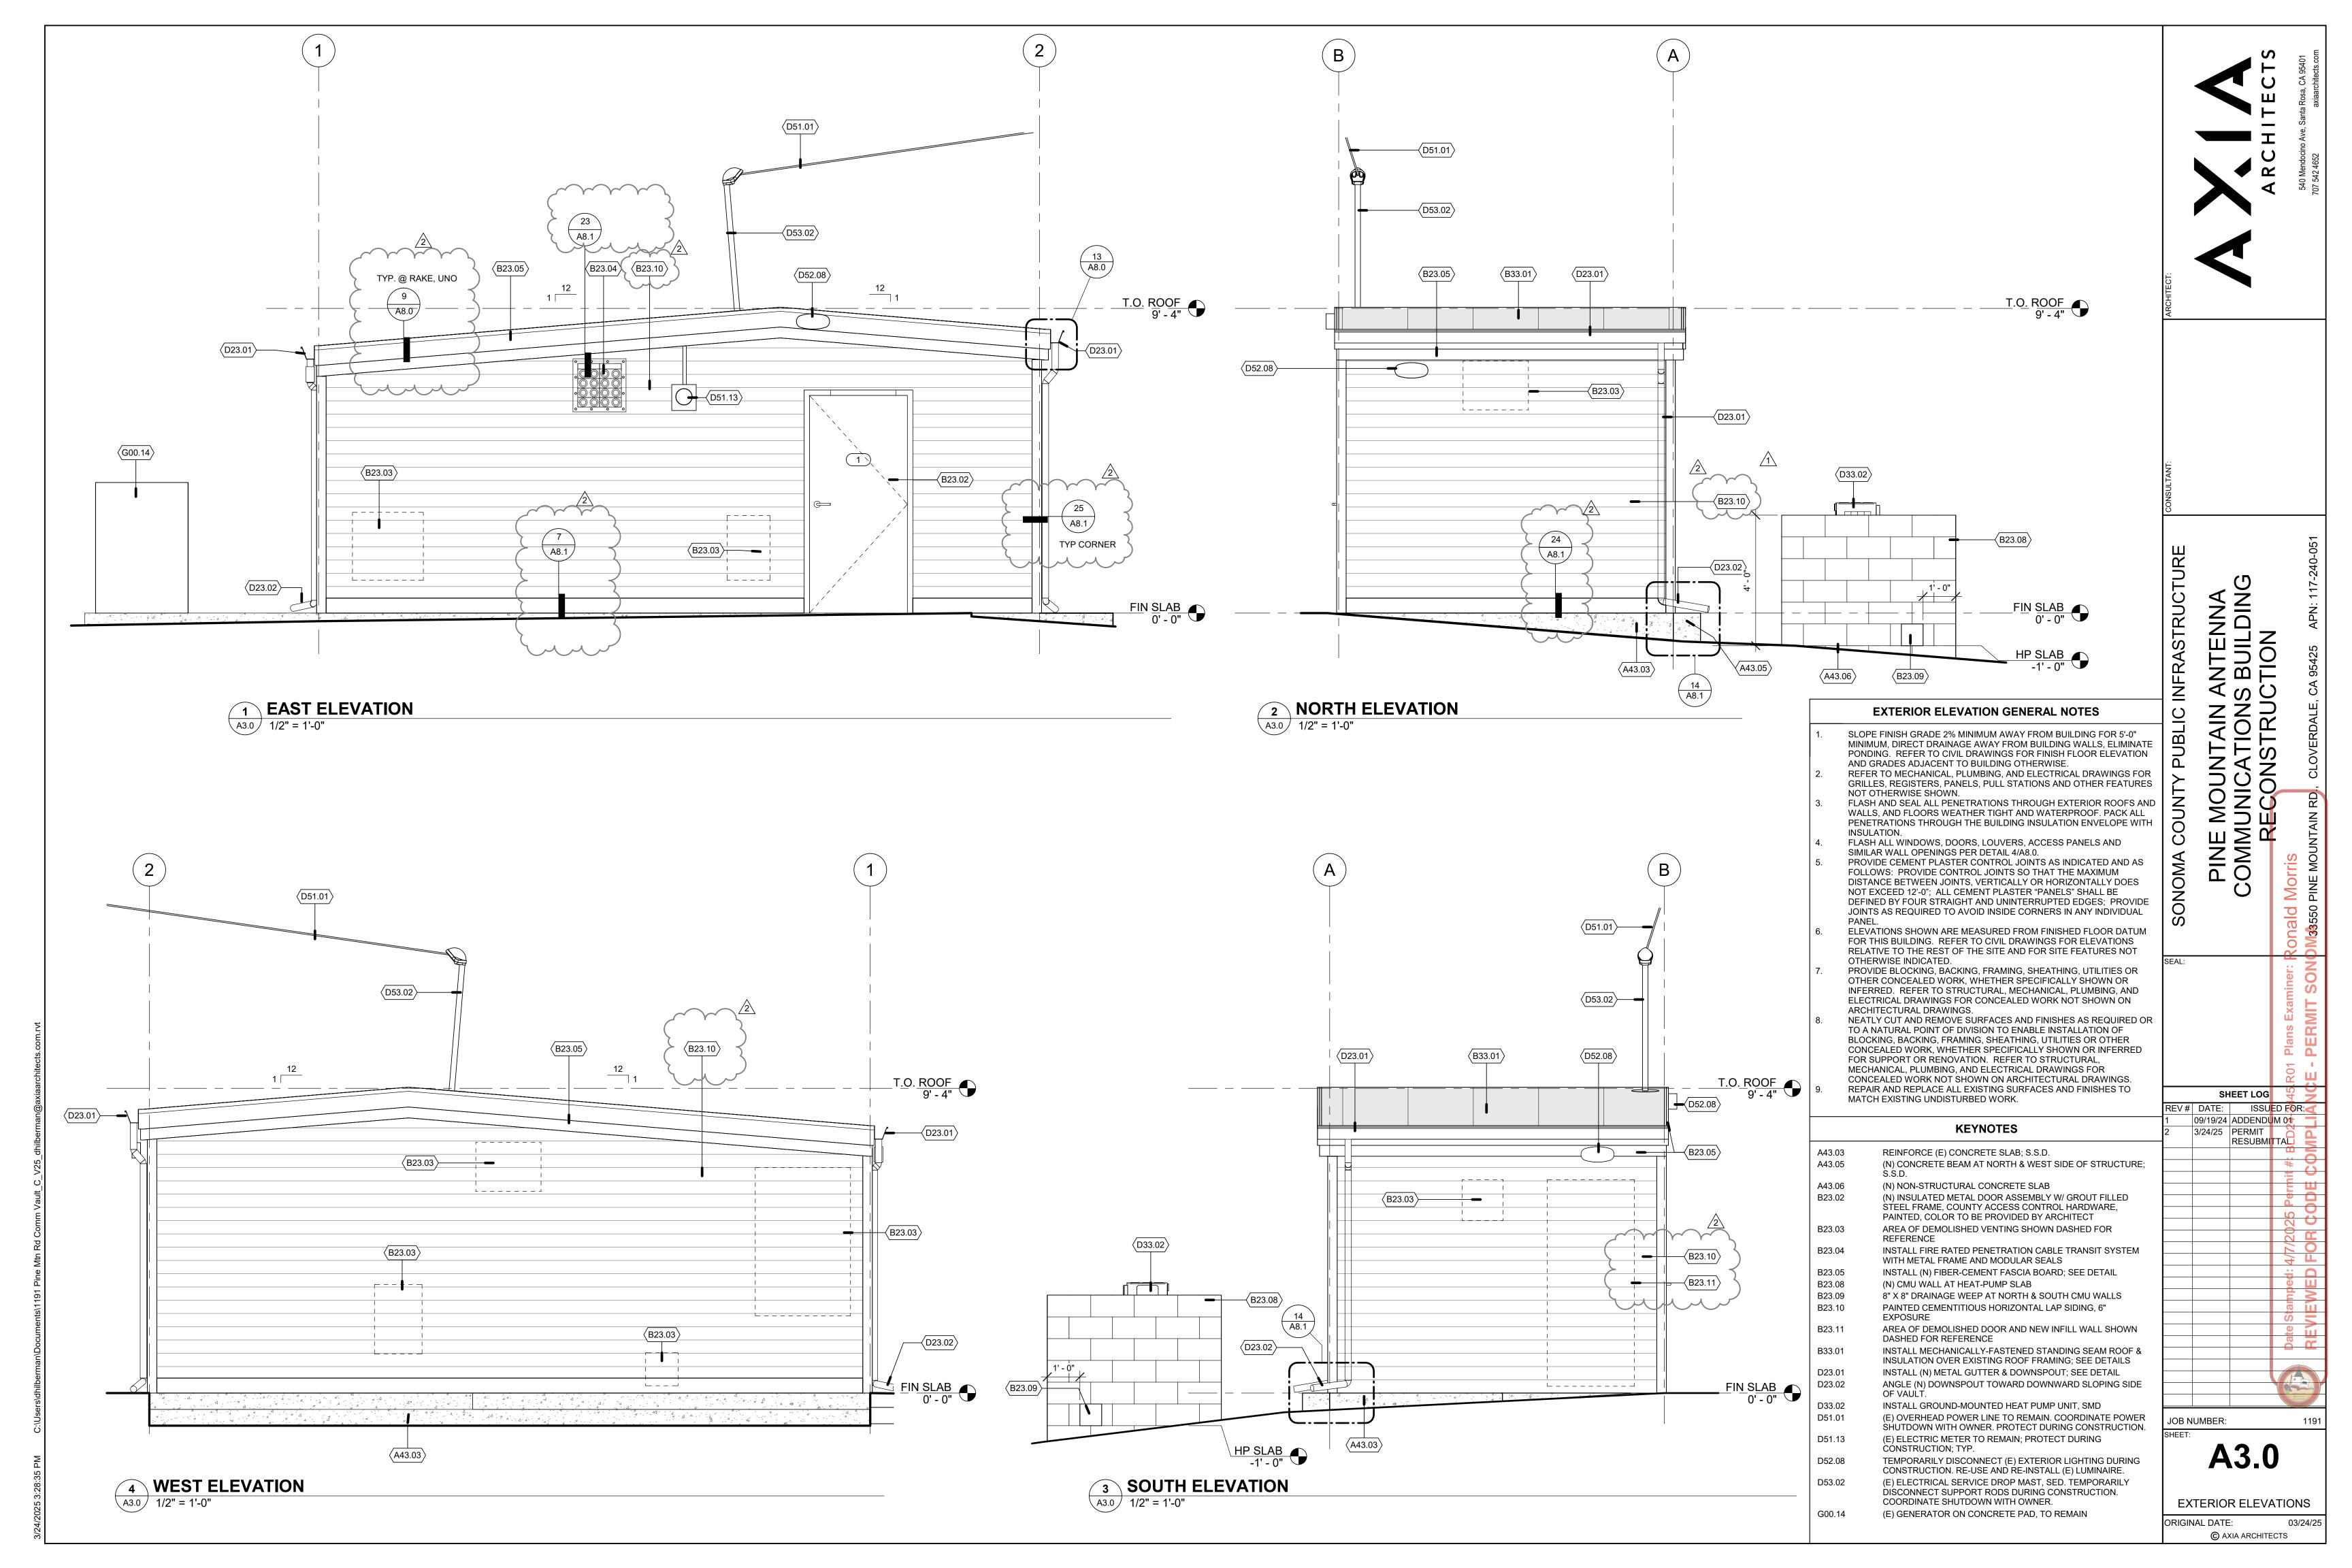

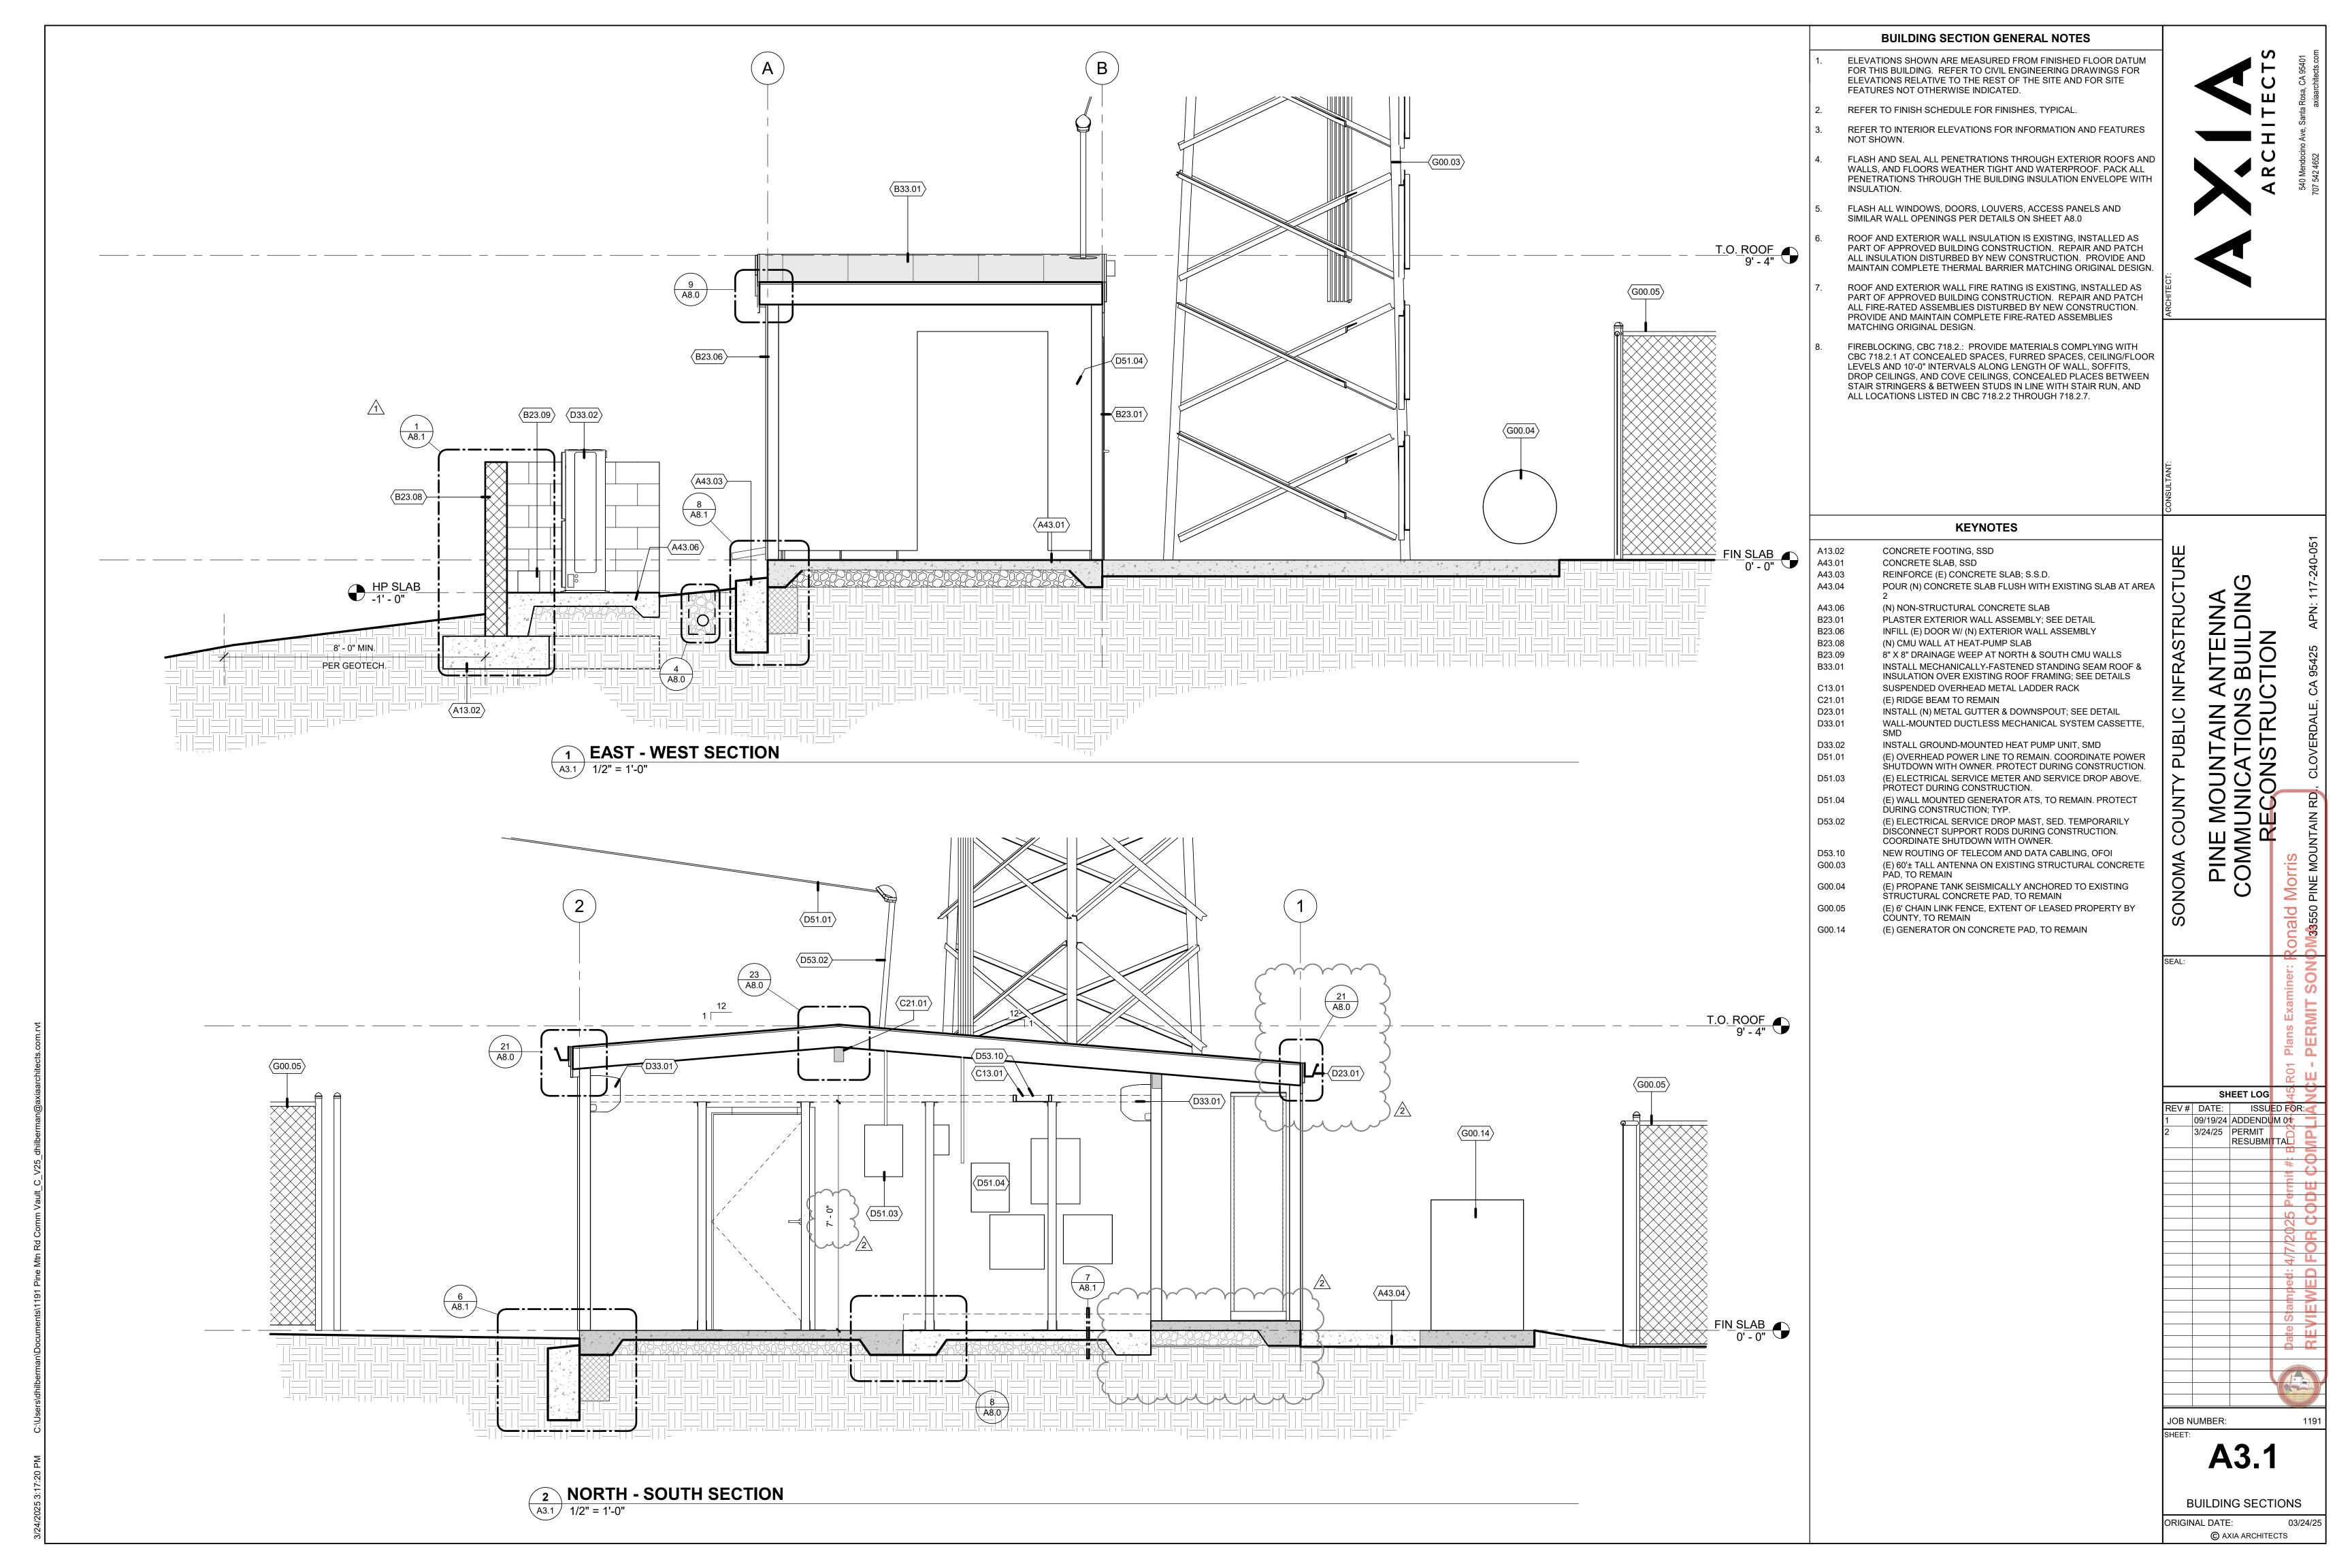


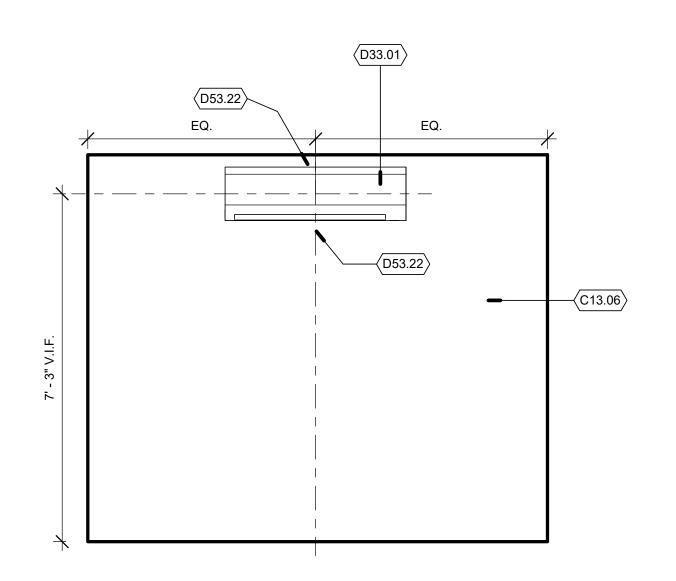


1 INTERIOR ELEVATION - NORTH
A5.0 1/2" = 1'-0"

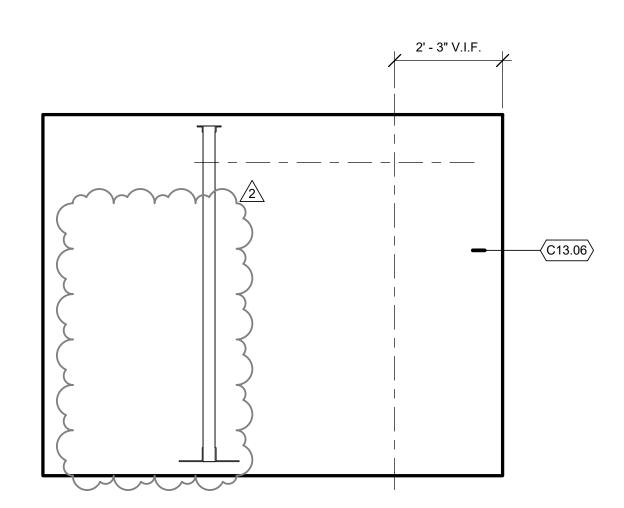

3 INTERIOR ELEVATION - SOUTH
A5.0 1/2" = 1'-0"

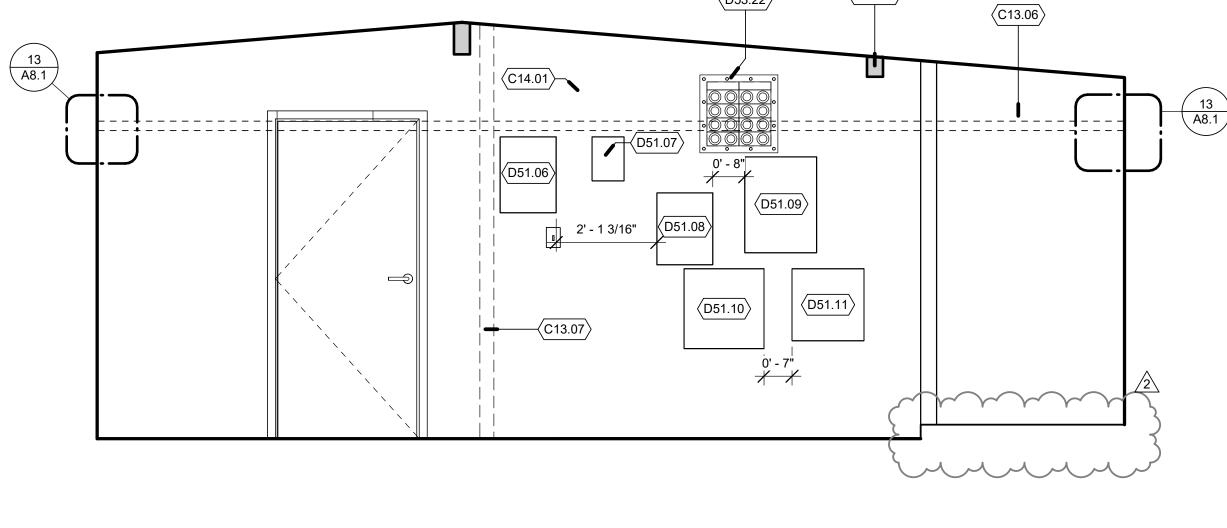

2 INTERIOR ELEVATION - EAST A5.0 1/2" = 1'-0"

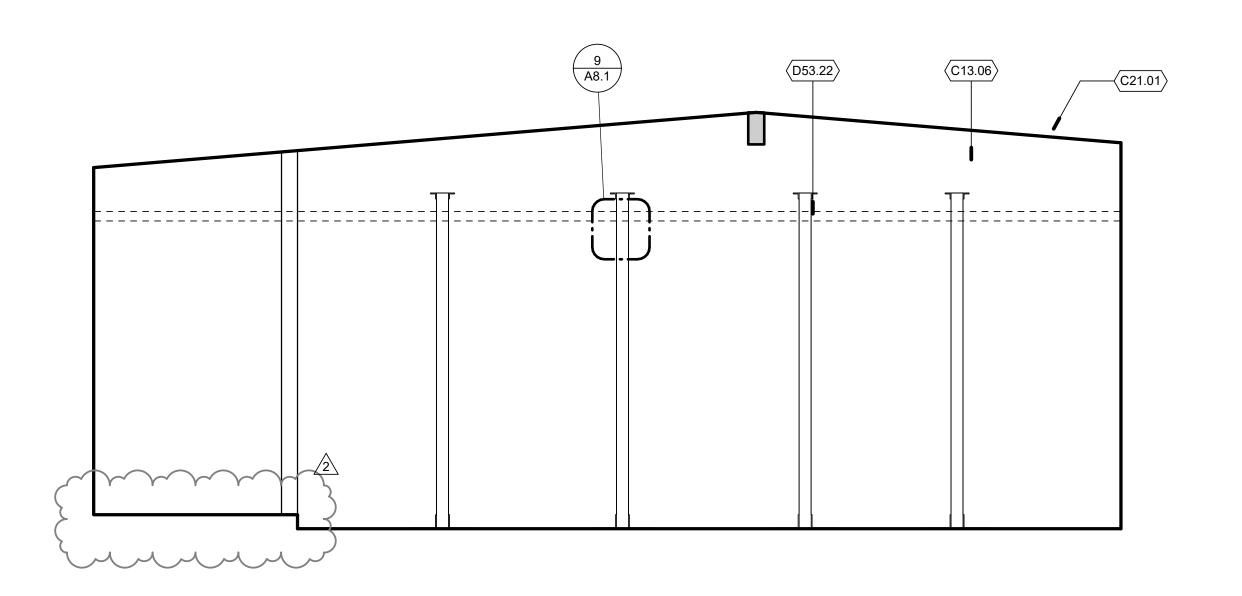

4 INTERIOR ELEVATION - WEST
A5.0 1/2" = 1'-0"

INTERIOR ELEVATION GENERAL NOTES

- REPAIR AND REPLACE ALL EXISTING SURFACES AND FINISHES TO MATCH EXISTING UNDISTURBED WORK.
- REFER TO MECHANICAL, PLUMBING, AND ELECTRICAL DRAWINGS FOR EQUIPMENT, DEVICES, LIGHT FIXTURES AND REGISTERS NOT OTHERWISE NOTED.



KEYNOTES

C13.06	PTD. GYP. BD.; TYP.
C13.07	APPROX. LINE OF TEMPORARY CONSTRUCTION PARTITION SHOWN DASHED FOR REFERENCE
C13.08	NEW STRUCTURAL HEADER; S.S.D.
C14.01	CONSTRUCT (N) TEMPORARY CONSTRUCTION PARTITION DURING PHASE 1 OF CONSTRUCTION. REMOVE THIS PARTITIO IN PHASE 4 OF CONSTRUCTION. SEE PHASING DIAGRAM.
C21.01	(E) RIDGE BEAM TO REMAIN
D33.01	WALL-MOUNTED DUCTLESS MECHANICAL SYSTEM CASSETTE, SMD
D51.06	(E) A/C LEAD LAG PANEL
D51.07	(E) MAIN SHUTOFF PANEL

(E) GENERATOR TRANSFORMER SWITCH (E) LINE SURGE SUPPRESSION D51.10 D51.11 (E) DEHYDRATOR PANEL D53.22 INSTALL NEW DATA CABLING TRAY AT CENTERLINE OF

(E) BREAKER PANEL

D51.07 D51.08


> BUILDING. MOUNT NEW CABLE TRAY ABOVE EXISTING TRAY.
> OWNER WILL TRANSFER ALL CABLING TO NEW TRAY AND DISASSEMBLE EXISTING. MAINTAIN EXISTING CABLE ENTRY POINT AT BUILDING EAST WALL.


SHEET LOG

JOB NUMBER: **A5.0**

INTERIOR ELEVATIONS

© AXIA ARCHITECTS

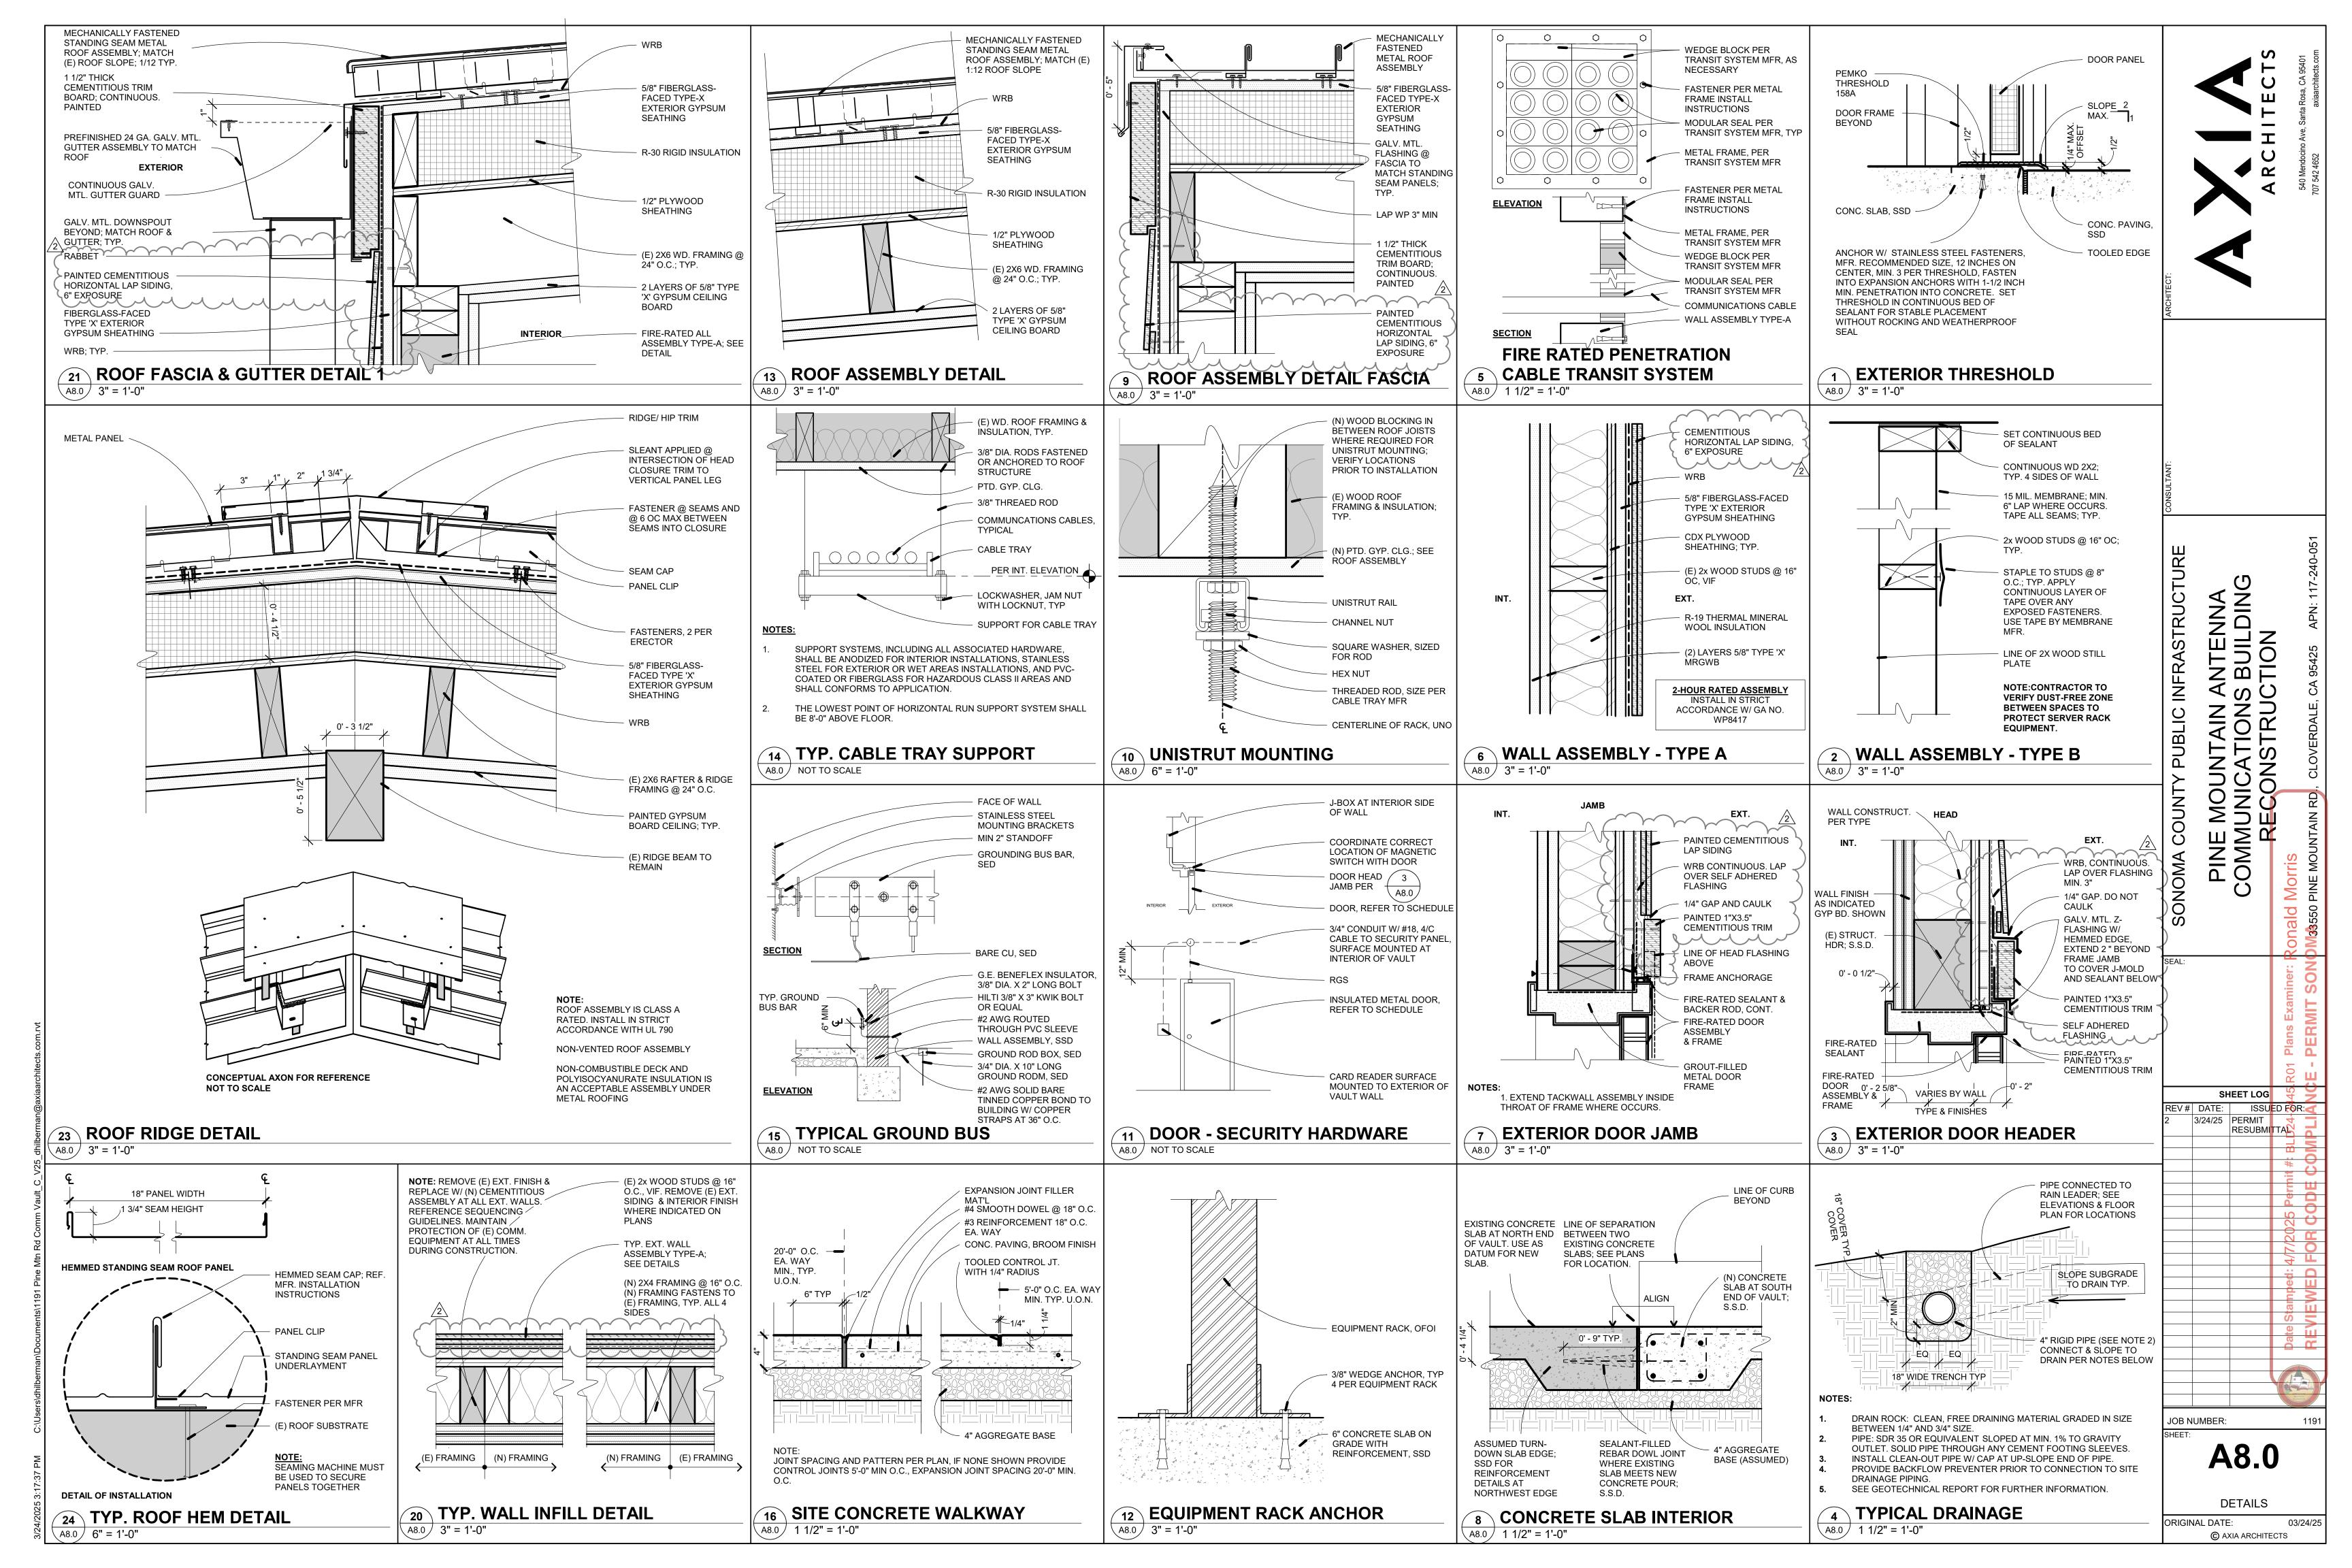

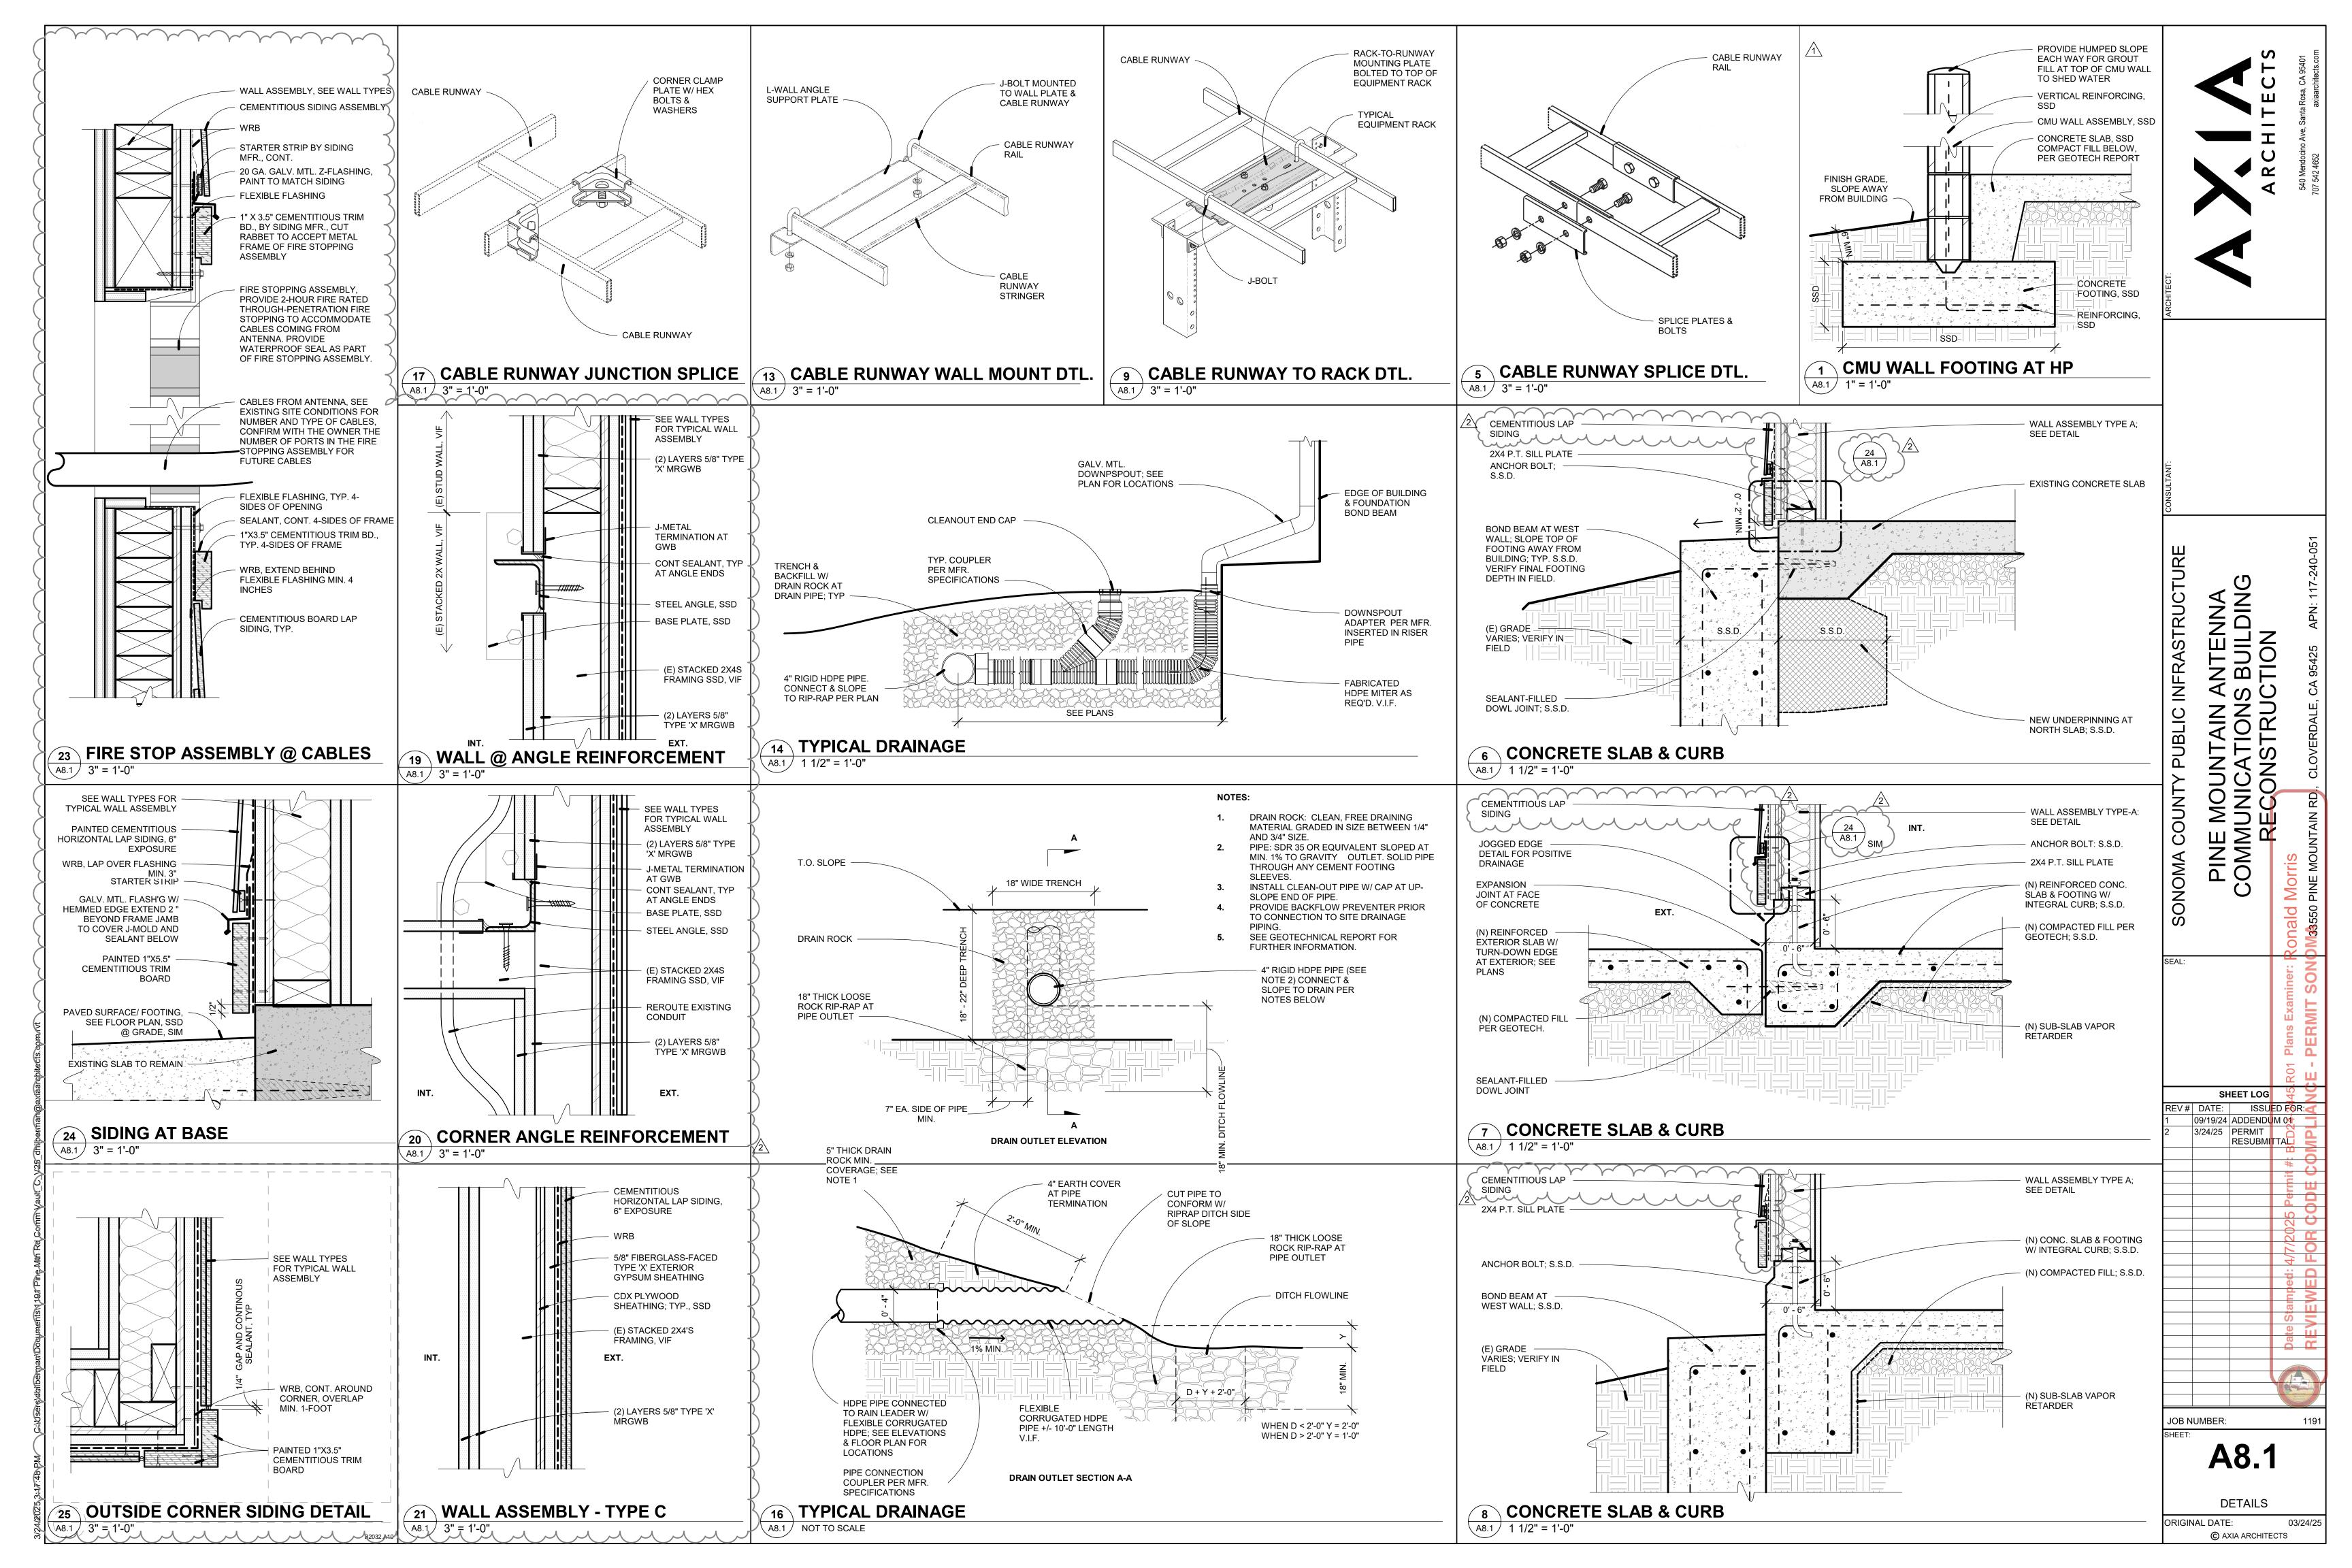

WOOD CONSTRUCTION (CARPENTRY)

1. EACH PIECE OF LUMBER SHALL BEAR THE STAMP OF THE WEST COAST LUMBER INSPECTION BUREAU (WCLIB) OR WESTERN WOOD PRODUCTS ASSOCIATION (WWPA) SHOWING GRADE MARK OR APPROVED EQUAL. BEAMS AND POSTS TO BE FREE OF HEART CENTER (FOHC). OTHER MATERIALS SHALL BE AS SHOWN BELOW:

SAWN LUMBER MEMBER	SPECIES AND MINIMUM GRADE, UNO	F _b (PSI)	F _v (PSI)	E (PSI)
6x POSTS	DOUGLAS FIR - #1	1200	170	1.6x10 ⁶
6x BEAMS	DOUGLAS FIR - #1	1350	170	1.6x10 ⁶
4x POSTS & BEAMS	DOUGLAS FIR - #1	1000	180	1.7x10 ⁶
2x JOISTS, RAFTERS	DOUGLAS FIR - #2	900	180	1.6x10 ⁶
P MATERIAL	DOUGLAS FIR - #2	900	180	1.6x10 ⁶
2x STUDS ≤ 10' HEIGHT	DOUGLAS FIR - STUD	700	180	1.4x10 ⁶
2x STUDS > 10' HEIGHT	DOUGLAS FIR - #2	900	180	1.6x10 ⁶

- IT SHALL BE THE RESPONSIBILITY OF THE CONTRACTOR TO ENSURE THE MAXIMUM MOISTURE CONTENT OF WOOD AT THE TIME OF INSTALLATION SHALL BE NOT MORE THAN 19%.
- NAILS TO BE ASTM F1667 (INCLUDING SUPPLEMENT S1) OF COMMON WIRE AND OF CENTERED FULL-ROUND HEADS WHERE NAILING IS SPECIFIED ON THE DRAWINGS. MACHINE-DRIVEN NAILS MEETING SIZE REQUIREMENTS ARE ACCEPTABLE. NAILS MUST NOT BE OVER-DRIVEN. PRE-DRILL NAIL HOLES WHERE WOOD TENDS TO SPLIT. NAILS AS SPECIFIED ON PLANS AND INCLUDING IN PTDF MATERIAL CONTAINING AMMONIA IN EXTERIOR APPLICATIONS SHALL BE TYPE 304 OR 316 STAINLESS STEEL. NAILS USED IN EXTERIOR APPLICATIONS OR IN INTERIOR PTDF SHALL BE HOT-DIPPED GALVANIZED PER ASTM A153.

WIRE NAIL	MINIMUM SHANK DIAMETER	MINIMUM NAIL LENGTH UNO	MINIMUM HEAD DIAMETER	TYPICAL NAIL APPLICATION, UNO
16d COMMON	0.162"	3½"	0.344"	FRAMING
10d COMMON	0.148"	3"	0.312"	FRAMING
10d COMMON	0.148"	PER <u>7/S1.2</u>	0.312"	SHEATHING
8d COMMON	0.131"	PER <u>7/S1.2</u>	0.281"	SHEATHING

- 4. IT SHALL BE THE RESPONSIBILITY OF THE CONTRACTOR TO ASSURE THAT THE METAL FRAMING CLIPS, HANGERS, ETC. ARE BY SIMPSON STRONG-TIE. NAILING SHALL BE IN ACCORDANCE WITH THE MANUFACTURER'S INSTRUCTIONS WITH A NAIL PROVIDED FOR EACH PUNCHED HOLE UNO. CONNECTORS AS SPECIFIED ON PLANS AND THOSE IN CONTACT WITH PTDF MATERIAL CONTAINING AMMONIA IN EXTERIOR APPLICATIONS SHALL BE TYPE 304 OR 316 STAINLESS STEEL. ALL OTHER CONNECTORS USED IN EXTERIOR APPLICATIONS OR INTERIOR PTDF SHALL BE HDG (MINIMUM 2.0 oz/SQ FT) OR ZMAX (MINIMUM 1.85 oz/SQ FT PER ASTM A653). IN APPLICATIONS WHERE NON-AMMONIA TREATED WOOD IS DRY WHEN INSTALLED AND WILL REMAIN DRY IN-SERVICE A COATING THICKNESS OF 0.9 oz/SQ FT MAY BE
- WOOD SCREWS SHALL CONFORM TO ANSI/ASME B18.6.1. PROVIDE PILOT HOLE 70% OF DIAMETER OF SCREW SHANK WHERE FASTENING HARDWOOD TIMBER SPECIES OR WHERE WOOD TENDS TO SPLIT. MINIMUM PENETRATION IS (10) DIAMETERS,
- BOLTS SHALL BE UNFINISHED MACHINE BOLTS PER ASTM A307. NUTS SHALL BE PER ASTM A563 AND OF STANDARD SIZE UNLESS NOTED OTHERWISE. LENGTH OF BOLTS SHALL BE SUCH THAT THE BOLT PROJECTION IS NOT LESS THAN 1/16" NOR MORE THAN 1/2" PAST END OF NUT. BOLT HOLES IN WOOD SHALL BE 1/32" LARGER THAN BOLT SIZES (UNO). PROVIDE STANDARD CUT WASHERS UNDER HEAD AND NUT WHERE BOLT HEADS WOULD BEAR ON WOOD. USE MALLEABLE IRON WASHERS WHERE EXPOSED TO VIEW OR NOTED. NUTS SHALL BE TIGHTENED WHEN PLACED AND RETIGHTENED BEFORE CLOSING IN OF WALLS OR OTHER CONSTRUCTION. DO NOT CRUSH WOOD WHEN TIGHTENING. BOLTS AS SPECIFIED ON PLANS AND THOSE IN CONTACT WITH PTDF MATERIAL CONTAINING AMMONIA IN EXTERIOR APPLICATIONS SHALL BE TYPE 304 OR 316 STAINLESS STEEL. ALL OTHER BOLTS USED IN EXTERIOR APPLICATIONS SHALL BE HOT-DIPPED GALVANIZED PER ASTM
- WOOD AGAINST CMU OR CONCRETE SHALL BE PRESSURE TREATED DOUGLAS FIR (PTDF) PER AWPA STANDARD U1. "USE CATEGORY" UC2 AT INTERIOR. "USE CATEGORY" UC3B AT EXTERIOR (NO GROUND CONTACT). CUT FACES SHALL BE BRUSH TREATED WITH EQUIVALENT PRESERVATIVE PRIOR TO INSTALLATION.
- DECKING MATERIAL AND FRAMING EXPOSED TO WEATHER TO BE PTDF AWPA "USE CATEGORY" UC3B OR REDWOOD, SAD.
- WOOD ADHESIVE SHALL BE WATER-PROOF, CARTRIDGE DISPENSED, MEETING APA PRODUCT SPECIFICATION AFG-01 OR ASTM D3498. LOCTITE "PL PREMIUM" OR EQUAL. FOR USE AT SUBFLOOR SHEATHING AND WHERE SPECIFICALLY NOTED FOR

ABBRE	EVIATIONS				
AB ABV	ANCHOR BOLT ABOVE	FTG GA	FOOTING GAGE or GAUGE	PNL PSF	PANEL POUNDS PER SQUARE FOOT
AC	AIR CONDITIONING	GALV	GALVANIZED	PSI	POUNDS PER SQUARE INCH
ADJ ADDL	ADJACENT ADDITIONAL	GB GL	GRADE BEAM GRIDLINE	PSL PTDF	PARALLEL STRAND LUMBER
ALT	ALTERNATE	GLB	GLUE LAMINATED BEAM	PIDE	PRESSURE TREATED DOUGLAS FIR
ALUM	ALUMINUM	GR	GRADE	PT	POINT
ARCH AYC	ARCHITECT ALASKAN YELLOW CEDAR	HD HDG	HOLD DOWN HOT-DIP GALVANIZED	R RBS	RADIUS REDUCED BEAM SECTION
@	AT	HDR	HEADER	RFTR	RAFTER
BF BLDG	BRACED FRAME BUILDING	HGR HK	HANGER HOOK	REF REINF	REFERENCE REINFORCING
BLK/BLKG	BLOCK/BLOCKING	HORIZ	HORIZONTAL	REQD	REQUIRED
BLW BM	BELOW BEAM	HSB HSG	HIGH STRENGTH BOLT HIGH STRENGTH GROUT	RET REV	RETAINING REVISION
BN	BOUNDARY NAIL	HSH	HORIZONTAL SLOTTED	RF	ROOF
BOT BRG	BOTTOM BEARING	HSS	HOLE HOLLOW STRUCTURAL	RWD S	REDWOOD AMERICAN STANDARD BEAM
BTWN	BETWEEN	поо	SECTION	SAD	SEE ARCHITECTURAL
BU	BUILT-UP	HT	HEIGHT	0.0	DRAWINGS
BYND C	BEYOND AMERICAN STANDARD	ID IJ	INSIDE DIAMETER I SHAPED WOOD BUILT	SB SC	SOLID BLOCK SLIP CRITICAL
	CHANNEL		UP TRUSS	SCD	SEE CIVIL DRAWINGS
CA CANT	CALIFORNIA CANTILEVER	INT JST	INTERIOR JOIST	SCHED SED	SCHEDULE SEE ELECTRICAL DRAWINGS
СВ	CARRIAGE BOLT	JT	JOINT	SEOR	STRUCTURAL ENGINEER OF
CFS CIP	COLD FORMED STEEL CAST IN PLACE	KP L	KING POST STEEL ANGLE	SFRS	RECORD SEISMIC FORCE RESISTING
CGL	CERTIFIED GLUED LUMBER	Lb or #	POUND(s)	SFRS	SYSTEM
CJ	CONTROL JOINT CENTERLINE	LGMF	LIGHT GAGE METAL FRAMING	SHTG	SHEATHING
€ CJP	COMPLETE JOINT	LGMFC	LIGHT GAGE METAL	SIM SKYLT	SIMILAR SKYLIGHT
CI C	PENETRATION CEILING		FRAMING CONTRACTOR LIVE LOAD	SLD	SEE LANDSCAPE DRAWINGS
CLG CLR	CLEAR	LL LLH	LONG LEG HORIZONTAL	SMS SMD	SHEET METAL SCREW SEE MECHANICAL DRAWINGS
COL	COLUMN	LLV	LONG LEG VERTICAL	SOG	SLAB ON GROUND
CONC CONN	CONCRETE CONNECTION	LOC LS	LOCATION LAG SCREW	SPCG SPD	SPACING SEE PLUMBING DRAWINGS
CONT	CONTINUOUS	LSL	LAMINATED STRAND LUMBER	SPEC	SPECIFICATION
COORD	COORDINATE/ COORDINATION	LVL	LAMINATED VENEER LUMBER LIGHTWEIGHT CONCRETE	SQ SS	SQUARE SELECT STRUCTURAL
CMU	CONCRETE MASONRY UNIT	MAX	MAXIMUM	33	or STAINLESS STEEL
CSK CW	COUNTERSINK CUT WASHER	MB MBM	MACHINE BOLT METAL BUILDING	STGR	STANDARD
DBA	DEFORMED BAR ANCHOR	INIDINI	MANUFACTURER	STD STIFF	STANDARD STIFFENER
DBL DCW	DOUBLE DEMAND CRITICAL WELD	MC	MISCELLANEOUS CHANNEL	STL	STEEL
DEW	DOUGLAS FIR	MECH MEZZ	MECHANICAL MEZZANINE	STRUCT SW	STRUCTURAL SHEAR WALL
DIA or Ø	DIAMETER	MF	MOMENT FRAME	SYM	SYMMETRICAL
DIAG DIM	DIAGONAL DIMENSION	MFR MIN	MANUFACTURER MINIMUM	T&B T&G	TOP AND BOTTOM TONGUE AND GROOVE
DIST	DISTANCE	MISC	MISCELLANEOUS	THK	THICK
DJ DL	DOWEL JOINT DEAD LOAD	MIW MTL	MALLEABLE IRON WASHER METAL	THRD THRU	THREADED THROUGH
DN	DOWN	MU	MECH UNIT	TL	TOTAL LOAD
DO DWG	DITTO DRAWING	(N) N/A	NEW NOT APPLICABLE	TN TOC	TOE NAIL TOP OF CONCRETE
DWL	DOWEL	NO or #	NUMBER	TOF	TOP OF FRAMING
EA EE	EACH EACH END	NS NSG	NEAR SIDE NON-SHRINK GROUT	TOM TOP	TOP OF MASONRY TOP OF PLYWOOD
EF	EACH FACE	NTS	NOT TO SCALE	TOS	TOP OF STEEL
ELEC ELEV	ELECTRICAL ELEVATOR/ELEVATION	NWC O/	NORMAL-WEIGHT CONCRETE OVER	TOT	TOTAL
EMBED	EMBEDMENT	oc	ON CENTER	TU TYP	TILT UP TYPICAL
EQ EQUIP	EQUAL	OD	OUTSIDE DIAMETER	UNO	UNLESS NOTED OTHERWISE
ES	EQUIPMENT EACH SIDE	OH OPNG	OPPOSITE HAND OPENING	VERT VIF	VERTICAL VERIFY IN FIELD
EW	EACH WAY	OPP	OPPOSITE	VSH	VERTICAL SLOTTED HOLE
(E) EXP	EXISTING EXPANSION	OVS OW	OVERSIZED OTHERWISE	W W/	WIDE FLANGE STEEL BEAM WITH
EXT	EXTERIOR	OWT	OPEN WEB TRUSS	W/O	WITHOUT
FDN FIN	FOUNDATION FINISH	PA PA	PLATE or PROPERTY LINE POST ABOVE	WD WHS	WOOD WELDED HEADED STUD
FG	FINISH GRADE	PAF	POWER ACTUATED	WLD	WELDED
FLR FN	FLOOR FACE NAIL		FASTENERS	WP WS	WORK POINT/WATERPROOF
FOC	FACE OF CONCRETE	PEN PERP	PANEL EDGE NAIL PERPENDICULAR	WS WT	WOOD SCREW WEIGHT
FOM FOS	FACE OF MASONRY FACE OF STUD	PES	PANEL EDGE SCREWS	WTS	WELDED THREADED STUD
FRMG	FRAMING	PJP PLF	PARTIAL JOINT PENETRATION POUNDS PER LINEAR FOOT	WWR	WELDED WIRE REINFORCEMENT
FS	FAR SIDE	l ·	. JOHDO I EN EMELANTIOOT		

CONCRETE CONSTRUCTION

1. CONCRETE SHALL MEET THE FOLLOWING REQUIREMENTS:

LOCATION	MIN 28-DAY STRENGTH (PSI)	AGGREGATE SIZE	MAX WATER TO CEMENTITIOUS MATERIALS RATIO	MIN SACKS CEMENTITIOUS MATERIAL PER CUBIC YARD ⁴
STRUCTURAL				
INTERIOR SLAB ON GROUND ³	3,000	1"x#4	0.45	6.1
FOUNDATIONS (INCLUDING STEM WALLS)	3,000	1"x#4	0.53	5.0
TOPPING SLAB	4,000	³⁄₄"x#4	0.46	6.0
NON-STRUCTURA LEAN CONC FOR FTG BACKFILL	<u>-</u>	-	-	3.0

2. CONCRETE MIX DESIGN AND TESTING SHALL MEET THE REQUIREMENTS OF CBC SECTIONS 1705 AND 1903, ACI CODE-318, ACI SPEC-301, AND THESE SPECIFICATIONS. SUBMIT MIX DESIGN AND SUPPORTING DOCUMENTATION IN ACCORDANCE WITH ACI SPEC-301 AND ACI CODE-318 FOR REVIEW PRIOR TO PLACEMENT.

ASTM C150 TYPE II

OLIVILIVI.	ACTIVICIO ITI LII
AGGREGATE:	ASTM C33
FLY ASH:	ASTM C618 CLASS F
SLAG CEMENT:	ASTM C989 GRADE 100 OR 120
WATER:	ASTM C1602
ADMIXTURES:	ASTM C494, C260

CEMENT

- 3. CONCRETE MIX DESIGN FOR INTERIOR SLABS ON GROUND TO HAVE 25% TO 35% FLY ASH OR 30% TO 45% SLAG CEMENT SUBSTITUTED FOR CEMENT AT A POUND-FOR-POUND RATE. REPLACE 200 POUNDS OF SAND WITH 200 POUNDS % "(-) AGGREGATE TO REDUCE TOTAL SAND.
- 4. FLY ASH MAY BE SUBSTITUTED UP TO 25% FOR CEMENT AT A POUND-FOR-POUND RATE, UNLESS SPECIFIED OTHERWISE. DO NOT USE FLY ASH IN HIGH EARLY STRENGTH CONCRETE. SLAG CEMENT MAY BE SUBSTITUTED UP TO 45% FOR CEMENT AT A POUND-FOR-POUND RATE, UNLESS SPECIFIED OTHERWISE. DO NOT USE SLAG CEMENT IN HIGH EARLY STRENGTH CONCRETE.
- 5. UNDER SLAB VAPOR RETARDER TO BE ASTM E1745 CLASS A; 15 MILS MINIMUM THICKNESS: 0.01 U.S. PERMS MAXIMUM PERMEANCE. INSTALL PER ASTM E1643 AND MANUFACTURER'S RECOMMENDATIONS. PROVIDE "STEGO WRAP VAPOR BARRIER (15MIL)" OR APPROVED EQUIVALENT. RETARDER SHALL EXTEND TO FOOTINGS BUT NOT TO BOTTOM OF FOOTING OR INTO A COLD JOINT.
- REINFORCING STEEL SHALL CONFORM TO ASTM A615 GRADE 60 OR A706 GRADE 60. STEEL SHALL BE KEPT CLEAN AND FREE OF RUST. SECURELY TIE REBAR IN PLACE PRIOR TO CONCRETE PLACEMENT. SUBMIT SHOP DRAWINGS FOR REVIEW PRIOR TO INSTALLATION. WELDED REINFORCING STEEL SHALL BE ASTM A706 OR A615 MEETING CARBON REQUIREMENTS OF AWS D1.4. WELDING SHALL CONFORM WITH AWS D1.4. WELDED WIRE REINFORCEMENT SHALL CONFORM WITH ASTM A1064 AND SHALL BE LAPPED 12" MINIMUM.
- 7. CONCRETE SHALL BE KEPT CONTINUOUSLY WET FOR 48 HOURS, AFTER PLACEMENT, AND SHALL BE KEPT DAMP FOR 7 DAYS AFTER PLACEMENT. IN LIEU OF PONDING, SLABS EITHER MAY HAVE CURE/SEALER APPLIED IMMEDIATELY AFTER FINISHING (IF OTHER FINISHES ARE NOT AFFECTED) OR COVERED WITH CURING PAPER, FILM OR BURLAP. CURE SHALL BE OF A TYPE THAT WILL NOT BE DETRIMENTAL TO SEALERS TO BE APPLIED LATER.
- 8. ANCHOR BOLTS ASTM F1554 GRADE 36 THREADED ROD WITH DOUBLE NUTS OR ASTM A307 HEADED BOLTS. (NO "J" OR "L" BOLTS EXCEPT AT WOOD SILL PLATES). SECURELY TIE ANCHOR BOLTS IN PLACE PRIOR TO CONCRETE POUR.
- 9. WHERE INDICATED ON THE ARCHITECTURAL DRAWINGS AT TOPPING SLABS, XYPEX CHEMICAL CORPORATION "XYPEX ADMIX C-500" SHALL BE USED PER MANUFACTURER'S RECCOMENDATIONS.

CONCRETE MASONRY CONSTRUCTION (CMU)

- 1. CONCRETE MASONRY UNITS SHALL BE MEDIUM-OR LIGHT-WEIGHT CONFORMING TO ASTM C90, LATEST VERSION. UNITS TO BE DOUBLE OPEN END WHERE POSSIBLE AND SINGLE OPEN END OTHERWISE. ALL CELLS TO BE GROUTED SOLID. COMPRESSIVE STRENGTH OF MASONRY AT 28 DAYS, F'm, SHALL BE 1,500 PSI.
- GROUT TYPE SHALL BE COURSE CONFORMING TO ASTM C476, LATEST VERSION, HAVING A COMPRESSIVE STRENGTH OF 2,000 PSI MINIMUM IN 28 DAYS AND SHALL HAVE MINIMUM 6 SACKS OF CEMENT PER CUBIC YARD. ADD 1 POUND SIKA GROUT AID PER SACK OF CEMENT UP TO 6 POUNDS MAXIMUM PER CUBIC YARD.
- 3. MORTAR SHALL BE 1800 PSI MINIMUM TYPE M OR S CONFORMING TO ASTM C270, LATEST VERSION, AND PROPORTIONED TO OR WITH PROPERTY SPECIFICATIONS PER 2010 CBC SECTION 2103.
- 4. THE MINIMUM LAP SPLICE SHALL BE PER DRAWINGS. ALL STEEL, INCLUDING EMBEDS, SHALL BE POSITIONED AND TIED.

THOROUGHLY CONSOLIDATED BY VIBRATING IMMEDIATELY AFTER.

5. GROUT SHALL BE PLACED IN 48" LIFTS MAXIMUM WITHOUT CLEAN OUTS. MAXIMUM LIFT IS 8'-0" WITH CLEAN OUTS. GROUT FOR EACH POUR SHALL BE STOPPED 11/2" BELOW THE TOP OF THE LAST COURSE OF BLOCK. ALL GROUT TO BE

∖ WOOD FRAMING NOTES

- HEADERS, BEAMS, POSTS, TOP PLATE SPLICES, AND ETC., ARE PER 1/S1.2 AND 6/S1.2 WHERE NOT NOTED ON PLAN AND DETAILS. WALLS AT SEISMIC SEPARATIONS SHALL BE CONSIDERED EXTERIOR WALLS.
- ALL BEAMS AND JOISTS (EXCLUDING I JOISTS) SHALL BE SEAT CUT FOR FULL UNIFORM BEARING AT SUPPORTS, INCLUDING BEAM SEATS AND COLUMN CAPS.
- 3½" AND 5½" WIDTHS MAY BE SUBSTITUTED FOR 3½" & 5½" WIDTHS RESPECTIVELY, AT INDUSTRIAL APPEARANCE GRADE GLULAM MEMBERS UNO.
- 4. SEE 7/S1.2 FOR SHEATHING NAILING REQUIREMENTS. ALL NAILING NOT NOTED OR DETAILED OTHERWISE SHALL BE PER <u>8/S1.2</u> . NAIL LENGTH TO BE SUFFICIENT TO MEET CBC PENETRATION REQUIREMENTS. NAILS INTO PRESSURE TREATED MATERIAL SHALL BE HOT DIP GALVANIZED. NAILS AT BORATE TREATED LUMBER MAY BE CLEAR ZINC COATED. SEE SPECIFICATIONS FOR ADDITIONAL REQUIREMENTS AT EXTERIOR EXPOSURES.
- EXTERIOR STUD WALL SHALL BE 2x6 @ 16"oc UNLESS NOTED OTHERWISE INTERIOR BEARING WALLS AND SHEAR WALLS SHALL BE 2x6 @ 16"oc UNLESS NOTED OTHERWISE. SEE ARCHITECTURAL DRAWINGS FOR OTHER INTERIOR WALL FRAMING SIZES. COORDINATE STUD AND PLATE SIZES WITH THE REQUIREMENTS OF THE SHEAR WALL SCHEDULE.
- WOOD POST SIZES ARE TO MATCH BEAM AND STUD WIDTH, UNO. WHERE POST OCCURS ABOVE RAISED FLOOR, PROVIDE SOLID BLOCKING AT FLOOR FRAMING TO MATCH WIDTH OF POST. PEN PER G/S0.1TO POSTS AT ALL EXTERIOR WALLS AND INTERIOR SHEAR WALLS. POSTS AT HOLDOWNS TO BE FULL HEIGHT AND PER 9/S1.2
- FOR ROOF DRAINAGE, TOP OF FRAMING BETWEEN NOTED POINTS IS A STRAIGHT
- 8. ALL MECHANICAL SUPPLY AND RETURN OPENINGS TO BE BETWEEN FRAMING UNO.
- 9. THE CONTRACTOR SHALL VERIFY THAT THE MOISTURE CONTENT OF ALL FRAMING LUMBER AND SHEATHING MEET THE REQUIREMENTS OF THE SPECIFICATIONS AT THE TIME OF INSTALLATION AND AT CLOSE-IN. THE CONTRACTOR SHALL PROVIDE ALLOWANCE FOR DIFFERENTIAL SHRINKAGE BETWEEN FLOORS, ETC.

\ SHEAR WALL NOTES

- PEN = PLYWOOD/OSB SHEATHING EDGE NAILING. BLOCK ALL UNSUPPORTED EDGES WITH 2x MATERIAL UNO. BLOCK EDGES WITH 3x MATERIAL WHERE NAILING IS 4"oc OR LESS.
- 2. FIELD NAILING TO BE 12"oc UNO.

OR <u>10/S1.2</u> .

- 3. ALL SHEATHING NAILS TO BE COMMON WIRE. SEE F/S0.1 AND SPECIFICATIONS FOR OTHER NAIL REQUIREMENTS.
- ALL EXTERIOR WALLS NOT DESIGNATED AS SHEAR WALLS ON PLANS TO HAVE SHEATHING AND PEN NAILING PER SHEAR WALL TYPE 'A'.
- SHEAR WALL LENGTHS, WHERE NOTED, ARE MINIMUM. DO NOT LOCATE HOLDOWNS FROM THESE DIMENSIONS. SAD FOR ACTUAL WALL LENGTHS.
- EDGE NAIL WALL SHEATHING TO STUDS OR POSTS WITH HOLDOWNS.
- SHEAR WALLS MORE THAN ONE VERTICAL PANEL IN HEIGHT SHALL HAVE STAGGERED HORIZONTAL OR VERTICAL SPLICE JOINTS.
- ANCHOR BOLTS (AB) FOR SHEAR WALLS SHALL INCLUDE STEEL PLATE WASHERS, A MINIMUM OF 0.229 INCH BY 3 INCHES SQUARE IN SIZE, BETWEEN THE SILL PLATE AND NUT. THE HOLE IN THE PLATE WASHER IS PERMITTED TO BE DIAGONALLY SLOTTED WITH A WIDTH OF UP TO 3/16 LARGER THAN THE AB DIAMETER AND A SLOT LENGTH NOT TO EXCEED 1¾", PROVIDED A STANDARD CUT WASHER IS PLACED BETWEEN THE PLATE WASHER AND THE NUT. PLATE WASHER TO EXTEND WITHIN 1/2" OF SHEAR WALL SHEATHING UNO. PROVIDE OVERSIZED PLATE WASHER OR OFFSET AB AS REQUIRED. AT DOUBLE-SIDED SHEAR WALLS, STAGGER AB AS REQUIRED. AB TO BE PLACED A MINIMUM OF 4½" AND A MAXIMUM OF 12" FROM ENDS OF ALL SILL PLATES AND AT NOTCHES IN SILL PLATES.

	SHEAR WALL SCHEDULE							
sw	APA RATED NAILING		ANCHORAGE %"Ø BOLT FDN AT FRAMING				REMARKS	
	SHEATHING	(PEN)	2x SILL	3x SILL	16d	A35	SDS*	
$\langle A \rangle$	¹⁵ ⁄ ₃₂ " (32/16) EXP 1	10d @ 6"oc	48"oc	48"oc	8"oc	24"oc	18"oc	
$\langle B \rangle$	¹⁵ / ₃₂ " (32/16) EXP 1	10d @ 4"oc	32"oc	32"oc	6"oc	16"oc	12"oc	

CONCRETE MASONRY UNIT NOTES

- CONCRETE MASONRY UNIT CONSTRUCTION SHALL BE PER 7/S1.1 UNO. USE DOUBLE OPEN END WHERE POSSIBLE AND SINGLE OPEN END OTHERWISE. ALL CELLS TO BE GROUTED SOLID. ALL CMU TO BE LAID IN RUNNING BOND.
- 2. PROVIDE INVERTED BOND BEAM UNITS AT FOUNDATION LEVEL. SEE SPECIFICATIONS FOR CLEANOUT AND GROUTING REQUIREMENTS.
- 3. DOWELS FROM FOUNDATION ARE TO MATCH SIZE AND ALIGNMENT WITH THE WALL VERTICAL REINFORCEMENT. EXTEND DOWELS FROM FOUNDATION INTO WALL TO PROVIDE MINIMUM LAP WITH WALL VERTICAL REINFORCEMENT. INSTALL DOWEL BARS PER PLAN AND 7/S1.1 ALL DOWELS TO EXTEND TO THE LOWEST FOUNDATION REINFORCEMENT AND END WITH A STANDARD HOOK.
- 4. PROVIDE (2) #5 IN BOND BEAM UNITS AT THE TOPS OF ALL WALLS, UNO.
- 5. SAD FOR TYPE OF FINISH, LOCATION, COLOR, ETC. SEE SPECIFICATIONS

SPECIAL INSPECTION BY OWNERS NTESTING AGENCY

SPECIAL INSPECTIONS AND TESTING SHALL BE PERFORMED BY AN APPROVED AGENCY IN ACCORDANCE WITH CBC CHAPTER 17 AND THE STATEMENT OF SPECIAL INSPECTIONS AS REQUIRED BY CBC SECTIONS 1704.2.3 AND 1704.3 FOR BUILDING STRUCTURAL ELEMENTS SUMMARIZED AS FOLLOWS:

- 1. SPECIAL CASES PER CBC SECTION 1705.1.1 AND PRODUCT ICC REPORTS FOR ALL STRUCTURAL MATERIALS AND SYSTEMS REQUIRED TO BE INSTALLED IN ACCORDANCE WITH ADDITIONAL MANUFACTURER'S INSTRUCTIONS THAT PRESCRIBE REQUIREMENTS NOT CONTAINED IN THE CBC OR REFERENCED STANDARDS INCLUDING POST-INSTALLED ANCHOR BOLTS IN CONCRETE.
- WOOD CONSTRUCTION PER CBC SECTIONS 1705.5, 1705.12.1, AND 1705.13.2 INCLUDING NAILING, BOLTING, AND ANCHORING OF ALL DRAG STRUTS: TOP PLATE SPLICES, LEDGER SPLICES, SIMPSON HARDWARE, BRACES, AND HOLDOWNS; AND NAILING, BOLTING, AND ANCHORING OF ALL SHEAR WALLS, SHEAR PANELS, AND DIAPHRAGMS WHERE THE FASTENER SPACING OF THE SHEATHING IS 4" APART OR

\ EXISTING CONSTRUCTION NOTES

1. ORIGINAL CONSTRUCTION DRAWINGS WERE NOT AVAILABLE FOR REVIEW AT THE TIME THESE DOCUMENTS WERE PREPARED. EXISTING BUILDING CONDITIONS SHOWN ARE ASSUMED BASED ON INFORMATION PROVIDED BY OTHERS AND ASSUMPTIONS BASED ON PROBABLE CONSTRUCTION METHODS. ACTUAL FIELD CONDITIONS MAY VARY.

- 2. ALL WORK NOT INDICATED AS EXISTING (E) SHALL BE ASSUMED TO BE NEW (N).
- 3. ANY REMOVAL, CUTTING, DRILLING, ETC OF EXISTING WORK SHALL BE PERFORMED WITH GREAT CARE. SMALL TOOLS SHALL BE USED IN ORDER NOT TO JEOPARDIZE THE STRUCTURAL INTEGRITY OF THE STRUCTURE. IF STRUCTURAL MEMBERS OR MECHANICAL, ELECTRICAL, OR ARCHITECTURAL ELEMENTS NOT INDICATED FOR REMOVAL INTERFERE WITH THE NEW WORK. THE ARCHITECT/ENGINEER SHALL BE IMMEDIATELY NOTIFIED AND PRIOR APPROVAL SHALL BE OBTAINED BEFORE REMOVAL OF THE MEMBERS.
- DO NOT OVER CUT EXISTING WOOD, CONCRETE, MASONRY OR OTHER WORK TO REMAIN. CUTS SHALL BE MADE NEATLY TO A CORNER, THEN ALTERNATE MEANS SHALL BE USED TO REMOVE REMAINING MATERIAL. CONTRACTOR IS RESPONSIBLE FOR REPAIR/REPLACEMENT OF OVER CUT MATERIAL AS DIRECTED BY THE ARCHITECT AND/OR ENGINEER.
- EXISTING DAMAGED STRUCTURAL MEMBERS WHICH ARE UNCOVERED SHALL BE REPORTED TO THE ARCHITECT/ENGINEER FOR REVIEW AND REPAIR
- EXISTING CONCRETE SURFACE ABUTTING NEW CONCRETE SHALL BE ROUGHENED TO 1/4" AMPLITUDE AND THOROUGHLY CLEANED OF DUST, LOOSE AGGREGATE, LAITANCE, ETC.
- 7. EXISTING REINFORCING AND/OR STEEL EMBEDS THAT ARE EXPOSED DURING DEMOLITION SHALL BE WIRE-BRUSHED AND FOREIGN MATERIAL REMOVED PRIOR TO PLACEMENT OF NEW CONCRETE.
- REMODELING REQUIRES ASSUMPTIONS BE MADE REGARDING EXISTING CONDITIONS WHICH MAY NOT BE VERIFIABLE WITHOUT DESTROYING OTHERWISE ADEQUATE OR SERVICEABLE PORTIONS OF THE STRUCTURE. THIS ANALYSIS DOES NOT MAKE ANY GUARANTEE TO THE ADEQUACY OF THE STRUCTURAL DESIGN OF THE EXISTING BUILDING NOT SPECIFICALLY ADDRESSED IN THE STRUCTURAL CALCULATIONS, ZFA SHALL NOT BE RESPONSIBLE FOR UNSATISFACTORY PERFORMANCE OF EXISTING PORTIONS OF THE STRUCTURE NOT SPECIFICALLY ADDRESSED IN THE CONSTRUCTION DOCUMENTS.

N DESIGN CRITERIA

FLOOR LIVE LOAD: ROOF LIVE LOAD: <u>FUTURE SOLAR:</u> **RISK CATEGORY**

2022 CALIFORNIA CODE OF REGULATIONS, TITLE 24, PART 2 (CBC) 40 PSF (REDUCIBLE) 20 PSF (REDUCIBLE)

WIND DATA:

3 PSF

ULTIMATE WIND SPEED (3 SEC GUST) IN MPH: 95 WIND EXPOSURE: C INTERNAL WIND PRESSURE COEFFICIENT (GCPI) = ±0.18 COMPONENTS AND CLADDING DESIGN PRESSURES FOR SYSTEMS DESIGNED BY OTHERS SHALL COMPLY WITH THE "ASCE 7-16" DESIGN STANDARD

EARTHQUAKE DATA: SEISMIC IMPORTANCE FACTOR, I_e: 1.5 MAPPED SPECTRAL RESPONSE ACCELERATIONS: $S_S = 2.50$; $S_1 = 0.939$ SITE CLASS: C SPECTRAL RESPONSE COEFFICIENTS: $S_{DS} = 2.00$; $S_{D1} = 0.876$

DESIGN CATEGORY: F SEISMIC FORCE RESISTING SYSTEM(S): WOOD FRAMED SHEAR WALL RESPONSE MODIFICATION FACTOR(S): R = 6.5 SEISMIC RESPONSE COEFFICIENT(S), C_S = 0.308 (ULTIMATE)

ANALYSIS PROCEDURE USED: EQUIVALENT LATERAL FORCE

∖ GENERAL NOTES

- 1. REFER TO SHEETS <u>S1.1</u> AND <u>S1.2</u> FOR STANDARD DETAILS OF CONSTRUCTION. REFER TO THE PROJECT SPECIFICATIONS FOR MATERIALS AND METHODS.
- 2. BUILDING DIMENSIONS SHOWN ARE FOR GENERAL REFERENCE ONLY. SEE ARCHITECTURAL DRAWINGS (SAD) FOR ALL ACTUAL BUILDING DIMENSIONS. ANY DISCREPANCIES ARE TO BE BROUGHT TO THE ATTENTION OF THE ARCHITECT/ENGINEER SO CLARIFICATION CAN BE MADE PRIOR TO COMMENCING
- 3. STRUCTURAL DRAWINGS SHALL NOT BE SCALED. ALL DIMENSIONS AND FIT SHALL BE DETERMINED AND VERIFIED BY THE CONTRACTOR PRIOR TO COMMENCING
- 4. DETAILS NOT FULLY OR SPECIFICALLY SHOWN SHALL BE OF SAME NATURE AS OTHER SIMILAR CONDITIONS.
- 5. REFER TO ARCHITECTURAL DRAWINGS FOR SIDEWALK SLABS AND DIMENSIONS.
- 6. COORDINATION OF MECHANICAL, ELECTRICAL, PLUMBING, AND SITE UTILITY SYSTEMS WITH THE STRUCTURAL SYSTEM IS THE RESPONSIBILITY OF THE GENERAL CONTRACTOR. USE DETAILS ON SHEETS <u>\$1.1</u> THROUGH <u>\$1.2</u>. AT CONDITIONS WHERE THESE DETAILS DO NOT APPEAR TO APPLY, NOTIFY THE STRUCTURAL ENGINEER PRIOR TO INSTALLATION. AT CONDITIONS WHERE FIELD MODIFICATIONS OF MECHANICAL, ELECTRICAL, PLUMBING, OR SITE UTILITIES AFFECT STRUCTURAL SYSTEMS, NOTIFY STRUCTURAL ENGINEER PRIOR TO INSTALLATION.
- 7. VERIFY WEIGHTS AND LOCATIONS OF MECHANICAL UNITS WITH MECHANICAL ENGINEER PRIOR TO PLACEMENT. UNITS VARYING OVER 10% IN WEIGHT SHALL BE REVIEWED BY THE STRUCTURAL ENGINEER PRIOR TO INSTALLATION (MECHANICAL WEIGHTS SHOWN ARE MAXIMUM). CONTRACTOR TO VERIFY MECHANICAL UNIT SIZES AND WEIGHTS AS INSTALLED PRIOR TO INSTALLATION OF SPECIAL FRAMING TO ENSURE CORRECT PLACEMENT UNDER CURBS, ETC.
- 8. SHORING AND BRACING DESIGN, MATERIALS AND INSTALLATION SHALL BE PROVIDED BY THE GENERAL CONTRACTOR, AND SHALL BE ADEQUATE FOR ALL LOADS. LEAVE IN PLACE AS LONG AS MAY BE REQUIRED FOR SAFETY AND UNTIL FINAL STRUCTURAL CONSTRUCTION IS COMPLETED.
- 9. SPECIAL INSPECTIONS ARE REQUIRED PER D/S0.1AND THE TESTING AND
- 10. STRUCTURAL OBSERVATION PER CBC SECTION 1704.6 IS NOT REQUIRED. NOTIFY ZFA FOR REVIEW PRIOR TO COVERING ABOVE LISTED WORK. PROVIDE 2

WORKING DAYS MINIMUM SCHEDULING NOTICE PRIOR TO REVIEW DATE.

\setminus FOUNDATION NOTES

1. ALLOWABLE (ASD) FOUNDATION DESIGN PRESSURES ARE

SHALLOW FOOTINGS: DEAD LOAD + LIVE LOAD = 2.500 PSF DEAD LOAD + LIVE LOAD + LATERAL = 3,333 PSF

2. ALL SOILS WORK SHALL BE DONE IN ACCORDANCE WITH THE SPECIFICATIONS AND THE REQUIREMENTS OF THE GEOTECHNICAL REPORT NOTED BELOW, AND CHAPTER 18 OF THE CBC. ALL FOUNDATIONS SHALL BEAR ON FIRM, UNDISTURBED, NATIVE SOILS OR ENGINEERED FILL AT OR EXCEEDING DEPTHS SHOWN ON THE DRAWINGS. ENGINEERED FILL TO BE COMPACTED PER GEOTECHNICAL REPORT INCREASE FILL AND OR FOOTING DEPTH AS REQUIRED BY GEOTECHNICAL ENGINEER. ALL FOOTING EXCAVATIONS SHALL BE AS NEAT AS PRACTICABLE MAXIMUM OVER EXCAVATION IN WIDTH SHALL BE LESS THAN 12 INCHES OR 25% OF FOOTING WIDTH, WHICH EVER IS LESS. 6 INCHES MAXIMUM PER SIDE. LARGER OVER-EXCAVATIONS IN WIDTH SHALL BE FILLED WITH ADDITIONAL REINFORCED CONCRETE AS DIRECTED BY THE ENGINEER, OR FORMWORK SHALL BE PROVIDED. OVER-EXCAVATIONS IN DEPTH MAY BE FILLED WITH LEAN CONCRETE OR COMPACTED APPROVED BACKFILL. ALL LOOSE SOILS SHALL BE REMOVED FROM EXCAVATIONS PRIOR TO PLACEMENT OF REINFORCING OR CONCRETE. GEOTECHNICAL REPORT BY:

BRUNSING ASSOCIATES, INC. REPORT NO. 12520.09 DATED: MARCH 21 2022 **UPDATE LETTER DATED: MARCH 12 2024**

3. TYPICAL SLAB: 5" CONCRETE REINFORCED WITH #4 @ 16"oc EACH WAY AT MID-DEPTH OVER VAPOR RETARDER (PER SPECIFICATIONS) AND 4" MINIMUM FREE DRAINING COMPACTED CRUSHED ROCK ON SUBGRADE PER THE GEOTECHNICAL RECOMMENDATIONS, AND AS APPROVED BY THE GEOTECHNICAL ENGINEER. DO NOT DRIVE CONCRETE TRUCKS OR LARGE SCREED MACHINES ON VAPOR RETARDER WITHOUT ADDITIONAL BUFFER MATERIAL AND APPROVAL FROM THE STRUCTURAL ENGINEER.

SHEET INDEX

S0.1 GENERAL NOTES AND SPECIFICATIONS

S1.1 TYPICAL CONCRETE AND CMU DETAILS S1.2 MODERNIZATION WOOD

S2.1 FOUNDATION AND ROOF FRAMING PLAN

03/24/2025

PINE N COMM

SHEET LOG REV # DATE: ISSUED FOR:

09/19/24 ADDENDUM 04 3/21/25 PERMIT RESUBMITTAL

JOB NUMBER:

GENERAL NOTES AND SPECIFICATIONS

ORIGINAL DATE: FEBRUARY 28, 2022

10) NEW SLAB TO EXISTING SLAB


	SCREW ANCHOR IN 2500 PSI MIN CONCRETE							
ANCHOR TYPE	ANCHOR AND PILOT HOLE DIA	MINIMUM EMBEDMENT H _{nom}	MINIMUM EDGE DIST C _{min}	MINIMUM SPCG S _{min}	MINIMUM CONCRETE THICKNESS H _{min}	MINIMUM INSTALL TORQUE (FT-LB)	MAXIMUM INSTALL TORQUE (FT-LB)	
	1/4"	1%"	1½"	1½"	31/4"	10	24	
CIMPCON	3/8"	2½"	13/4"	3"	4"	10	50	
SIMPSON TITEN HD	1/2"	31/4"	1¾"	3"	5"	10	65	
(ICC-ESR	5/8"	4"	13/4"	3"	6"	10	100	
2713)	3/4"	5½"	1¾"	3"	8¾"	20	150	
	1/4"	1%"	1½"	1½"	3¼"	10	18	
HILTI	3/8"	2½"	1½"	3"	4"	10	40	
KH-EZ	1/2"	3"	1¾"	3"	4¾"	10	45	
(ICC-ESR	5/8"	31/4"	13/4"	4"	5"	10	85	
3027)	3/4"	4"	1¾"	4"	6"	20	95	

3/16 "Ø OVS HOLE AT STL THICKER THAN 12GA (1/8") MAX 1/16 "Ø OVS ANCHOR PER PLAN & HOLES OTHERWISE **DETAILS** HOLE DEPTH TOP OF CONC PER MFR EDGE OF CONC -AS OCCURS

- 1. INSTALL SCREW ANCHORS PER MANUFACTURER'S INFORMATION AND ICC REPORT INSTRUCTIONS. SPECIAL INSPECTION IS REQUIRED PER SECTION 1705 OF THE CBC AND THE REQUIREMENTS OF THE ICC REPORTS. INSTALLED ANCHORS SHALL BRING CONNECTED PLIES INTO FIRM CONTACT, MEETING THE INSTALL TORQUE BUT NOT EXCEEDING THE MAXIMUM INSTALL TORQUE.
- 2. CONTRACTOR TO VERIFY MINIMUM EDGE DISTANCES, SPACING AND THICKNESS ARE IN ACCORDANCE W/ SCHEDULE PRIOR TO INSTALLING ANCHOR.
- 3. HOLES TO BE DRILLED W/ ROTARY DRILL ONLY. WHEN INSTALLING DRILLED-IN ANCHORS IN EXISTING REINFORCED CONCRETE, USE CARE AND CAUTION TO AVOID CUTTING OR DAMAGING THE EXISTING REINFORCING BARS. MAINTAIN A REASONABLE CLEARANCE BETWEEN REINFORCEMENT AND THE DRILLED-IN ANCHOR. FILL ABANDONED HOLES W/ HIGH STRENGTH GROUT.
- 4. THE SPECIAL INSPECTOR SHALL PERFORM PERIODIC/CONTINUOUS INSPECTION IN ACCORDANCE WITH TABLE 1705.3. THE SPECIAL INSPECTOR SHALL INSPECT ANCHOR TYPE, ANCHOR DIMENSIONS, HOLE CLEANLINESS, EMBEDMENT DEPTH, CONCRETE TYPE, CONCRETE COMPRESSIVE STRENGTH, DRILL BIT DIAMETER, HOLE DEPTH. EDGE DISTANCE(S), ANCHOR SPACING(S), CONCRETE THICKNESS, AND TIGHTENING


SCREW ANCHOR IN CONCRETE

ADHESIVE ANCHOR IN 2500 PSI MIN CONCRETE							
ADHESIVE	ANC	HOR	PILOT	MIN EMBED	MIN EDGE	MIN	MIN CONC
TYPE	THRD ROD	REBAR	HOLE	UNO H _{ef}	DISTANCE C _{min}	SPCG S _{min}	DEPTH H _{min}
	3/8 "Ø	#3	½ "ø	3"	1¾"	3"	H _{ef} + 2½"
	½"Ø	#4	5⁄8 "Ø	4"	1¾"	3"	H _{ef} + 31/8"
SIMPSON SET-XP	% "ø	#5	¾ "Ø	5"	1¾"	3"	H _{ef} + 3¾"
(ICC-ESR	¾ "Ø	#6	7∕8 "Ø	6"	1¾"	3"	H _{ef} + 4%"
2508)	%" ø	#7	1"Ø	7"	1¾"	3"	H _{ef} + 4"
,	1"Ø	#8	11/8 "Ø	8"	1¾"	3"	H _{ef} + 5%"
	1¼"Ø	#10	1% "Ø	10"	2¾"	6"	H _{ef} + 6 1/8"
	¾" ø	N/A	7∕ ₁₆ "Ø	3"	1¾"	1%"	
	N/A	#3	½ "ø	3"	1¾"	1%"	11 . 41/"
HILTI HIT-	½" ø	N/A	%16 "Ø	4"	1¾"	2½"	H _{ef} + 11/4"
HY 200R	N/A	#4	5∕8 "Ø	4"	1¾"	2½"	
(ICC-ESR	%" ø	#5	³∕₄ "Ø	5"	1¾"	31/8"	H _{ef} + 1½"
3187)	3/4 "Ø	#6	7∕8 "∅	6"	1¾"	3¾"	H _{ef} + 1¾"
	7∕8 "ø	#7	1"Ø	7"	1¾"	43/8"	H _{ef} + 2"
	1"Ø	#8	11/8 "Ø	8"	1¾"	5"	H _{ef} + 21/4"
	N/A	#9	1% "Ø	9"	1¾"	5%"	H _{ef} + 2¾"
	1¼"ø	N/A	1% "Ø	10"	1¾"	61/4"	⊓ef T ∠ 74
	N/A	#10	1½"Ø	10"	1¾"	61/4"	H _{ef} + 3"

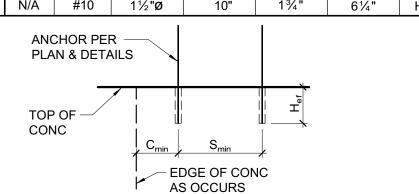

- 1. INSTALL ADHESIVE ANCHORS PER MANUFACTURER'S INFORMATION AND ICC REPORT.
- 2. CONTRACTOR TO VERIFY MINIMUM EDGE DISTANCES, SPACING, AND THICKNESS ARE IN ACCORDANCE W/ SCHEDULE PRIOR TO INSTALLING ANCHOR.
- 3. HOLES TO BE DRILLED W/ ROTARY DRILL ONLY. WHEN DRILLING HOLES IN EXISTING CONCRETE, USE CARE AND CAUTION TO AVOID CUTTING OR DAMAGING THE EXISTING REINFORCING BARS. MAINTAIN A REASONABLE CLEARANCE BETWEEN REINFORCEMENT AND THE DRILLED-IN ANCHOR. FILL ABANDONED HOLES W/ HIGH
- SPECIAL INSPECTION IS REQUIRED PER SECTION 1705 AND THE REQUIREMENTS OF THE ICC REPORTS. THE SPECIAL INSPECTOR SHALL PERFORM PERIODIC/CONTINUOUS INSPECTION IN ACCORDANCE WITH TABLE 1705.3. THE SPECIAL INSPECTOR SHALL INSPECT ANCHOR TYPE, ANCHOR DIMENSIONS, HOLE CLEANLINESS, EMBEDMENT DEPTH, CONCRETE TYPE, CONCRETE COMPRESSIVE STRENGTH, DRILL BIT DIAMETER, HOLE DEPTH, EDGE DISTANCE(S), ANCHOR SPACING(S), CONCRETE THICKNESS, AND ADHESIVE INJECTION.
- ADHESIVE ANCHOR IN CONCRETE 3/4" = 1'-0"

NOTES:

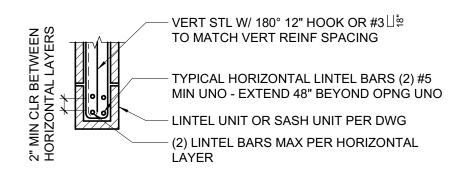


8" CMU LINTEL TYP VERT TRIM AT OPNG (2) #5 (MIN UNO) VERTICAL - TYP HORIZ STL IN BOND BARS AT UNIT - BEND & LAP AS FULL WALL HT W/ FTG . € OF CELL NOTED AT CORNERS & DOWELS TO MATCH. INTERSECTIONS STGR TRIM BAR LAPS 2 6 CORNER BARS (2) TO 24" MIN MAXIMUM OF 2 등 MATCH WALL REINF UNO PER CELL -CUT CMU FOR CONT BOND BM END HORIZ BAR W/-STD VERT HOOK CONDUIT OR PIPE IN UNREINF CELLS ONLY -(UNLESS DETAILED OTHERWISE). PROVIDE 1/2"

8" CMU (PLAN VIEW) - SINGLE LAYER VERT REINF

CLR FROM ANY REINF DO NOT TIE TO HORIZ REINF

8" CMU (PLAN VIEW) - SINGLE LAYER VERT REINF

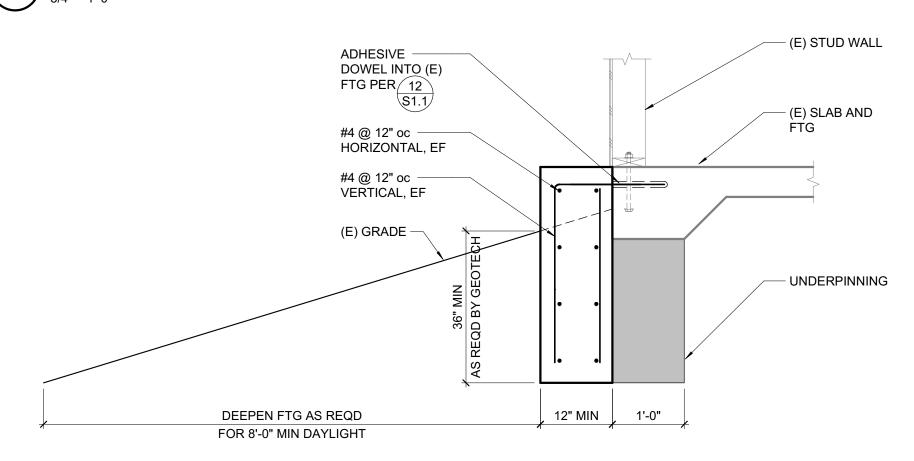



UNDERPINNING NOTES:

- 1. UNDERPINNING SHALL EXTEND INTO COMPETENT MATERIAL AS DETERMINED BY GEOTECH IN THE FIELD
- 2. CAST UNDERPINNING BLOCKS USING LEAN CONCRETE PER SPECS, DRY PACK AS REQUIRED FOR FULL BEARING BETWEEN UNDERPINNING AND FOUNDATION. SPACE 2'-0" LONG BLOCKS AT 4'-0" OC, MAX.

3. SEQUENCING NOTES:

- A. EXCAVATE AND PROVIDE UNDERPINNING BLOCKS (WIDTH TO MATCH FOOTING WIDTH ABOVE) STARTING FROM EDGE OF SERVER PIT AND EXTENDING AS FAR AS NECESSARY TO ESNURE FOUNDATIONS MEET THE REQUIREMENTS LAID OUT ABOVE (CONSULT WITH GEOTECHNICAL ENGINEER AS REQUIRED).
- B. CAST UNDERPINNING BLOCKS. ONCE BLOCKS HAVE REACHED FULL DESIGN STRENGTH PER SPECS, REMOVE SOIL BETWEEN UNDERPINNINGS AND CAST UNDERPINNING BLOCKS AT REMAINING VOID SPACES USING LEAN CONCRETE.
- C. AT THE INTERIOR FACE OF (E) FOUNDATION, PROVIDE A VERTICAL SOIL CUT IN ORDER TO ENSURE THE FLOOR SLAB REMAINS SUPPORTED. PROVIDE SHORING AT THE EXCAVATION AS REQUIRED TO MAINTAIN SOIL SUPPORT FOR THE SLAB AND ADJACENT FOOTING. BACKFILL THE EXCAVATION WITH COMPACTED FILL MATERAIL AS APPROVED BY THE GEOTECHNICAL ENGINEER.
- D. SUBMIT RFI IF SLAB ON GRADE IS UNDERMINED DURING UNDERPINNING.

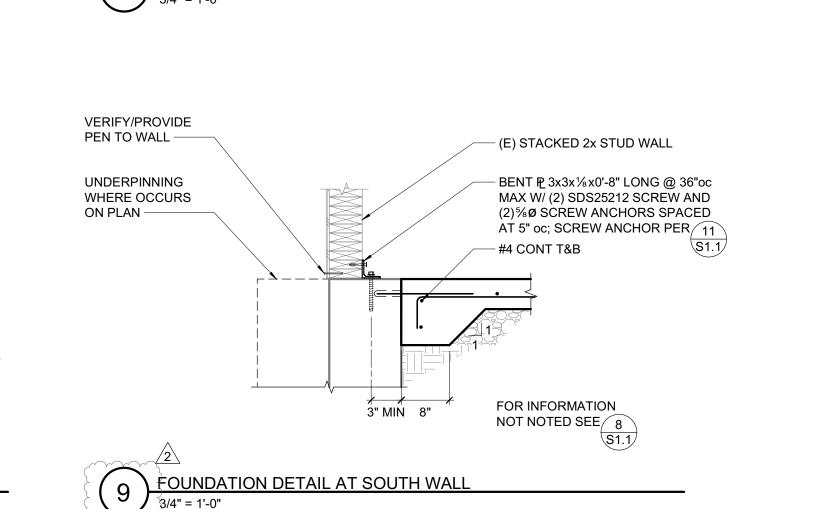

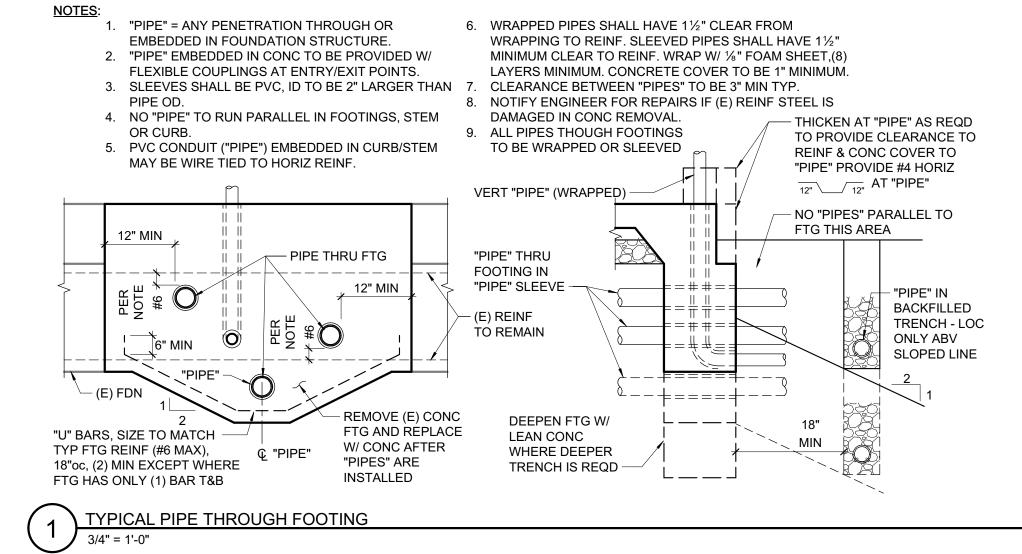

(E) SLAB -

SAWCUT

(E) SLAB

AT PIPE -


PIPE


SMD -


MINIMUM BAR LAPS FOR REINFORCING STEEL CONCRETE STRENGTH: 2500 PSI OR GREATER (STAGGER SPLICES) SIZE LAP LENGTH SIZE 61" #10 115" 37"X 77"


(CLASS B TOP BAR) BAR SPCG SHALL NOT BE LESS THAN 4x BAR DIA OR 4". ★ WHERE COVER NOT LESS THAN 1½", #5 LAP LENGTH = 31" CONC COVER FOR REINF STL CAST AGAINST EARTH OR GR EXPOSED TO EARTH (FORMED) OR WEATHER #5 & SMALLER #6 & LARGER -NOT EXPOSED TO EARTH OR WEATHER #5 & SMALLER-#6 & LARGER, & ALL BM STIRRUPS, COL TIES & SPIRALS _ 11/2"


ALL REINF SHALL EXTEND AS FAR AS POSSIBLE. WHERE BAR SPLICES ARE REQUIRED, BARS SHALL BE LAPPED PER SCHEDULE ABOVE UNLESS DETAILED OTHERWISE. WHERE REINF TERMINATES AT END OF MEMBER, REINF SHALL END IN A STD 90° OR

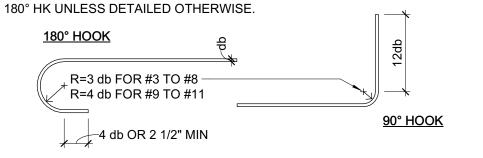

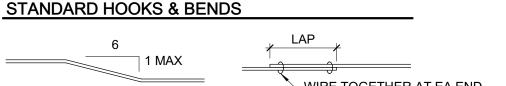

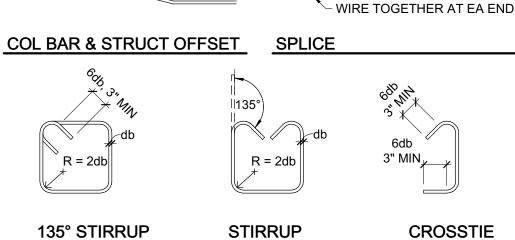

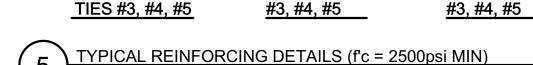

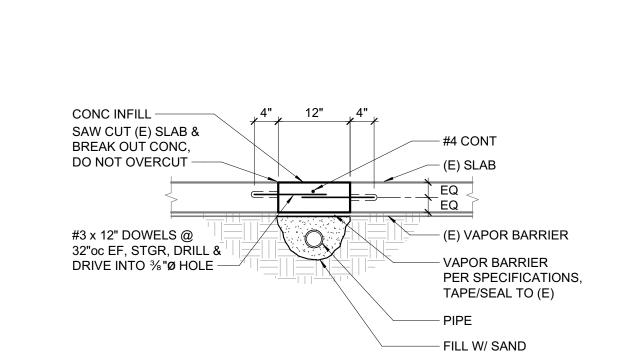

NEW PIPE AT EXISTING FOUNDATION


NO PIPES ALLOWED THROUGH (E)


BE AT (E) FOUNDATION REMOVE &

REPLACE (E) FOUNDATION PER

FOUNDATIONS IF PIPE LOCATION MUST



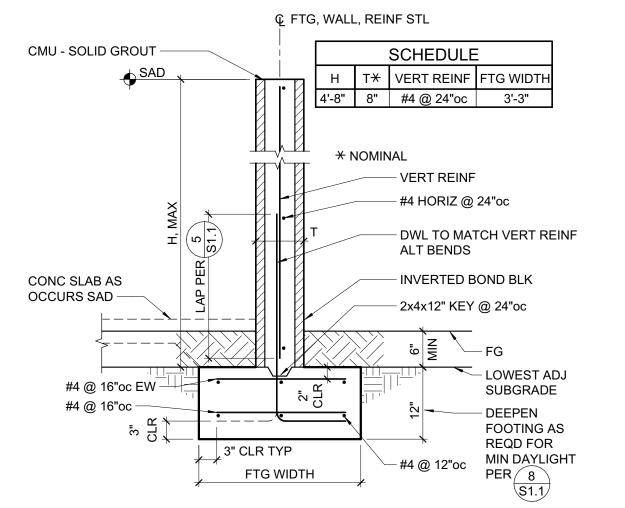

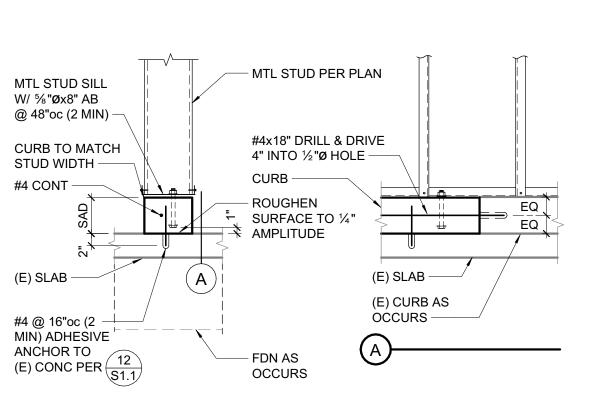

NEW CURB AT EXISTING SLAB


SHEET LOG REV# DATE: ISSUED FOR: 09/19/24 ADDENDUM 04 3/21/25 PERMIT RESUBMITTAL

JOB NUMBER:


TYPICAL CONCRETE AND CMU DETAILS ORIGINAL DATE: FEBRUARY 28, 2022


3/4" = 1'-0"


3/4" = 1'-0"

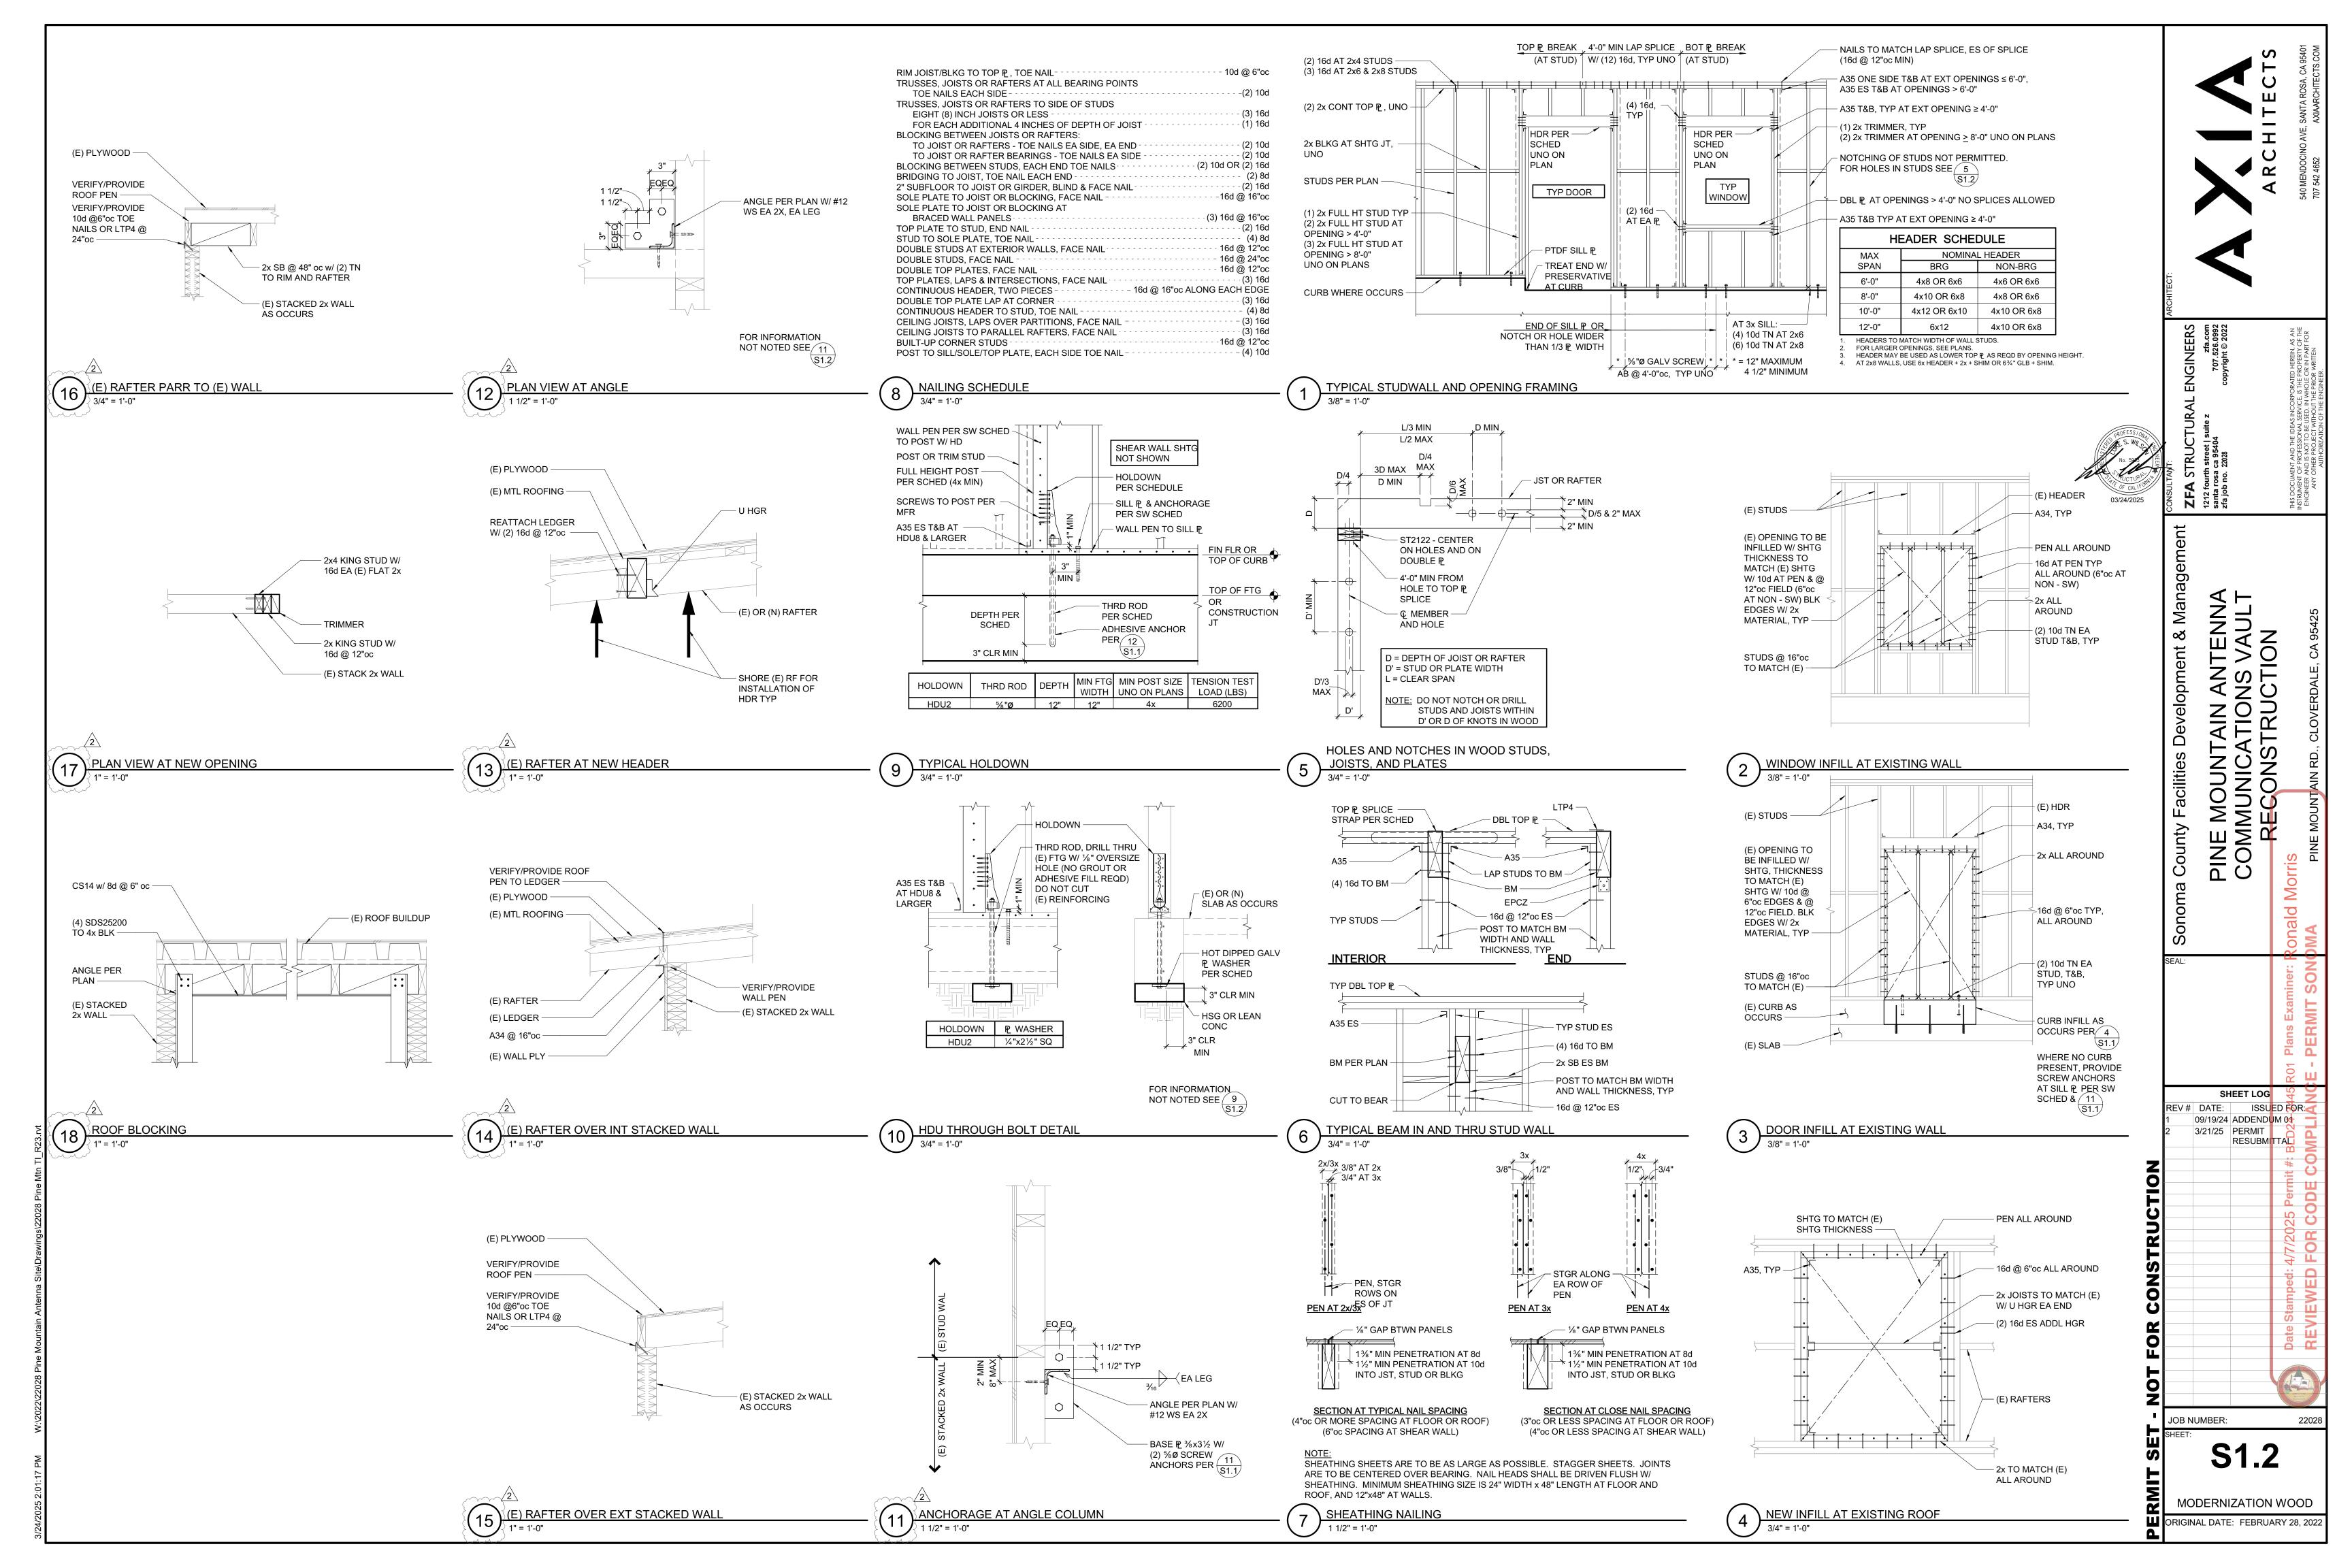

SHEAR WALL SCHEDULE								
OW ADA DATED					CHORA	GE		DEMARK
SW	APA RATED SHEATHING	NAILING (DEN)	%"ø BC	LT FDN	,	AT FRAMING	G.	REMARK
	SHEATHING	(PEN)	2x SILL	3x SILL	16d	A35	SDS *	
$\langle A \rangle$	¹⁵ / ₃₂ " (32/16) EXP 1	10d @ 6"oc	48"oc	48"oc	8"oc	24"oc	18"oc	
$\langle B \rangle$	¹⁵ / ₃₂ " (32/16) EXP 1	10d @ 4"oc	32"oc	32"oc	6"oc	16"oc	12"oc	

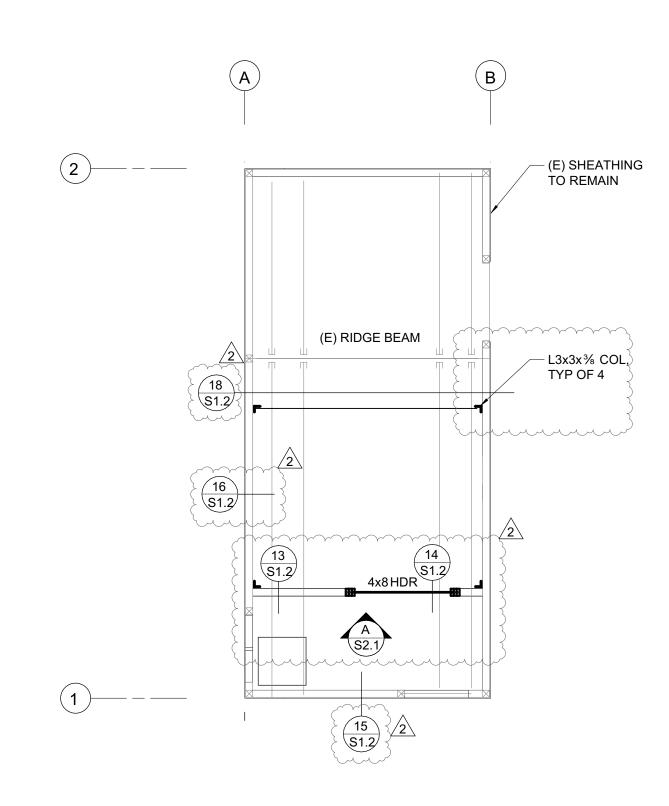

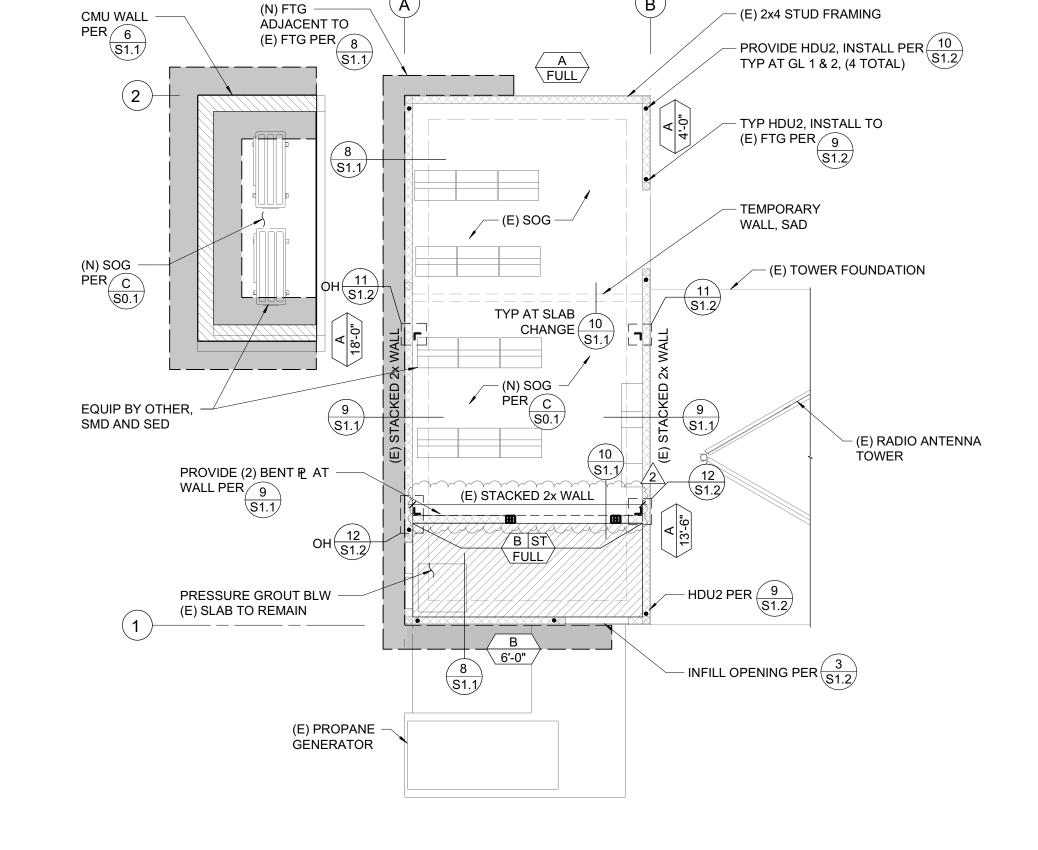

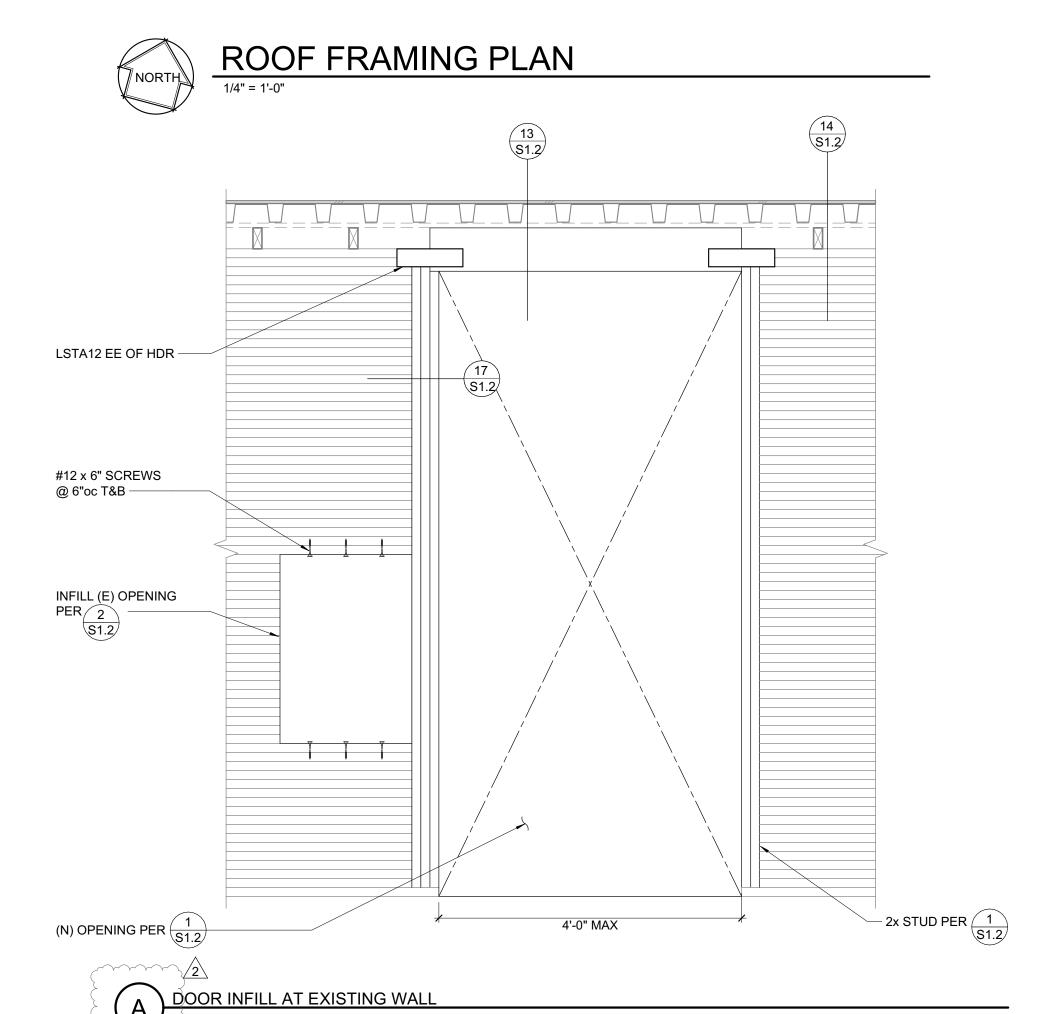



FOUNDATION PLAN

SHEAR WALL SCHEDULE NOTES:

1. AT EXISTING SHEAR WALLS, CONTRACTOR TO VERIFY EXISTING SHEATHING FOR DEFINED LENGTH. VERIFY EXISTING SHEAR WALL NAILING FOR SHEAR WALL TYPES B THRU C UNO. VERIFY EXISTING SHEAR WALL ANCHORAGE AT ALL EXPOSED CONDITIONS ONE LOCATION MINIMUM PER SHEAR WALL LINE, SEE PLANS FOR ADDITIONAL VERIFICATION REQUIREMENTS.

AT EXISTING SHEAR WALL DESIGNATING ADDITIONAL NAILING/ANCHORAGE. ADD ADDITIONAL PEN AT EXISTING SHEATHING PANEL EDGES TO MEET NAILING PER SCHEDULE. AT EXISTING PLATE ANCHORAGE, PROVIDE ADDITIONAL FASTENERS TO MEET ANCHORAGE PER SCHEDULE AT EXISTING FOUNDATION SILL PLATES, PROVIDE %Ø SCREW ANCHORS PER 11/S1.1TO MEET MINIMUM SPACING PER SCHEDULE.

FOUNDATION PLAN NOTES:

- 1. REFER TO SHEETS <u>S0.1</u>, <u>S1.1</u>, AND <u>S1.2</u> FOR GENERAL NOTES AND TYPICAL DETAILS. THE FOLLOWING DETAIL REFERENCES ARE PROVIDED FOR THE CONTRACTOR'S CONVENIENCE ONLY. ALL GENERAL NOTES AND TYPICAL DETAILS NOTED ABOVE ARE APPLICABLE AND SHALL BE FOLLOWED.
- 2. COORDINATE ALL DIMENSIONS WITH ARCHITECTURAL DRAWINGS PRIOR TO CONSTRUCTION. NOTIFY ARCHITECT/ENGINEER OF ANY DISCREPANCIES.
- 3. COORDINATE WITH ARCHITECTURAL DRAWINGS PRIOR TO CONSTRUCTION. NOTIFY ARCHITECT/ENGINEER OF ANY DISCREPANCIES.
- 4. PLUMBING AND ELECTRICAL CONDUIT AND GROUND STRAP SHALL NOT BE LAID WITHIN FOUNDATIONS. NO UTILITY PIPES OR CONDUITS SHALL BE LOCATED THRU COLUMN FOOTINGS OR FRAME FOOTINGS. NO VERTICAL OR HORIZONTAL PIPES OR CONDUITS SHALL BE LOCATED THROUGH STEEL FRAMES, STEEL COLUMNS, OR STEEL BASE PLATES. PROVIDE FURRING AND/OR THICKENED CONCRETE WHERE REQUIRED TO CLEAR UTILITY SYSTEMS. NOTIFY STRUCTURAL ENGINEER/ARCHITECT PRIOR TO ANY INSTALLATION NOT CONFORMING TO THESE DETAILS.

PIPES THROUGH FOOTINGS SHALL BE PER 1/S1.1 AND 2/S1.1.

PIPES AT SLAB ON GRADE SHALL BE PER 3/S1.1.

- 5. CONDUIT OR PLUMBING NOT ALLOWED WITHIN CONC FILL ON HOLLOW CORE PANEL DECK.
- 6. FLOOR PRESSURE GROUT ALTERNATE NOTE: FLOOR FINISH TO BE APPLIED OVER REMEDIATED SLAB TO BE PER ARCHITECTURAL DRAWINGS. SLAB REPAIR SHALL RESTORE SLAB TO LEVEL CONDITION WITH ±1/8" MAX VARIANCE.

PLAN LEGEND							
SYMBOL	REFERENCE DETAIL	DESCRIPTION					
		INDICATES FOUNDATION.					
88)		INDICATES GRIDLINE AT FACE OF WALL.					
MU 1,000#		INDICATES APPROXIMATE LOCATION, SIZE AND MAXIMUM WEIGHT OF MECHANICAL UNIT. SEE MECHANICAL DRAWINGS FOR ANCHORAGE AND ADDITIONAL INFORMATION.					
		INDICATES EXISTING FOUNDATION.					
		INDICATES EXISTING FRAMING.					
		INDICATES CMU WALL					
A 10'-0"	1/S1.2 G/S0.1	INDICATES (E) SHEAR WALL, REMOVE (E) T-11 AND PROVIDE NEW PLYWOOD WITH NAILING/ANCHORAGE PER SW SCHED WITH MINIMUM LENGTH DEFINED.					



SHEET LOG REV# DATE: ISSUED FOR:


1 09/19/24 ADDENDUM 04


2 3/21/25 PERMIT RESUBMITTAL


JOB NUMBER:


FOUNDATION AND ROOF FRAMING PLAN


ORIGINAL DATE: FEBRUARY 28, 2022

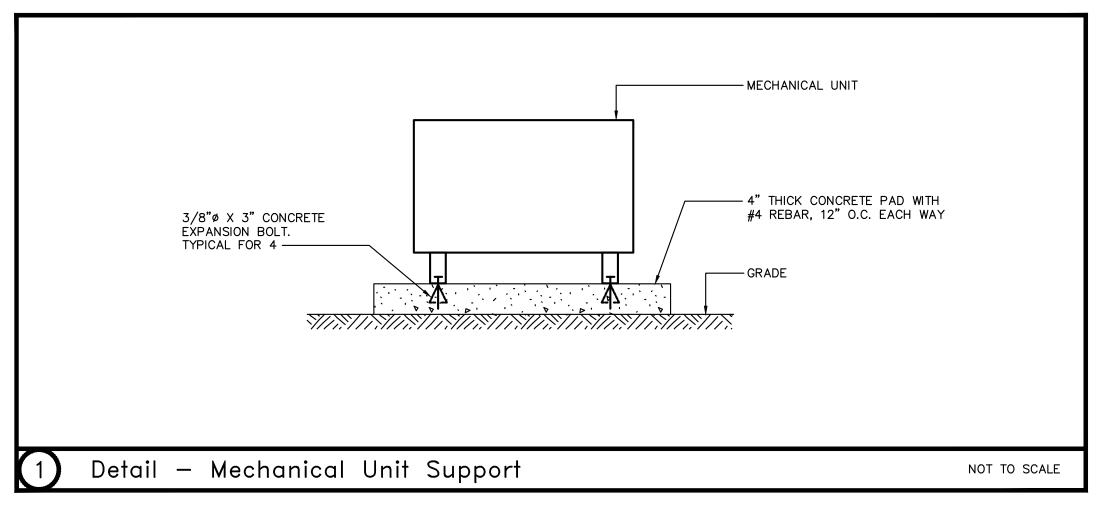

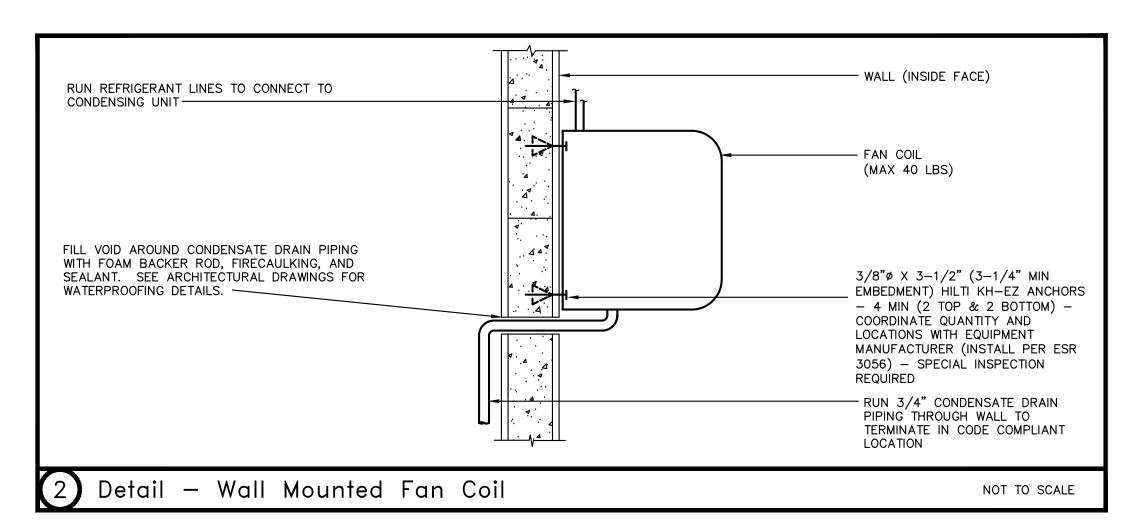

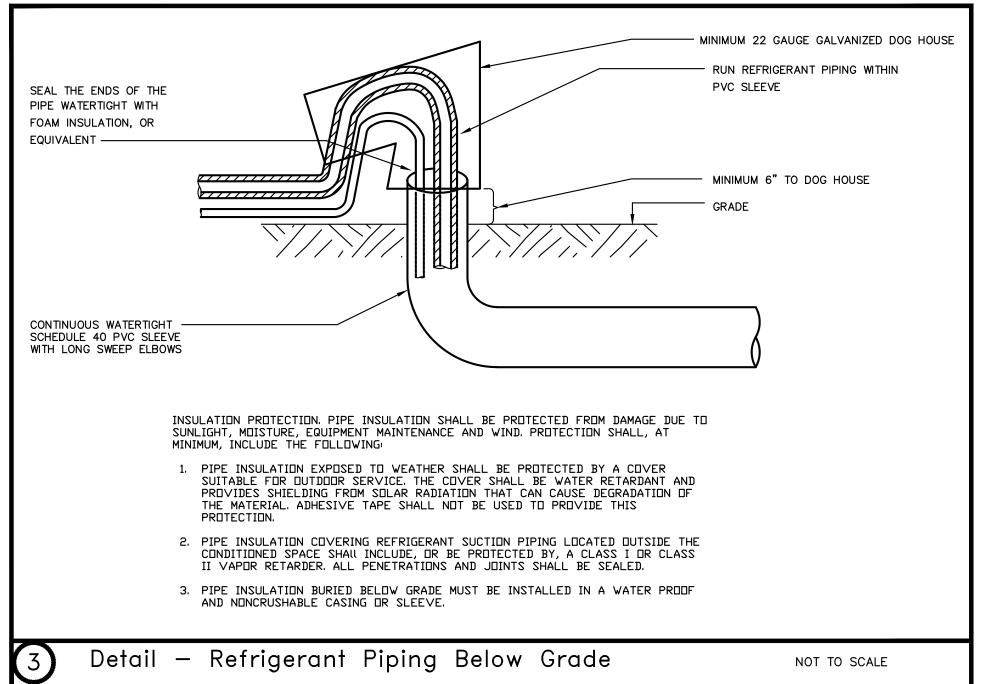

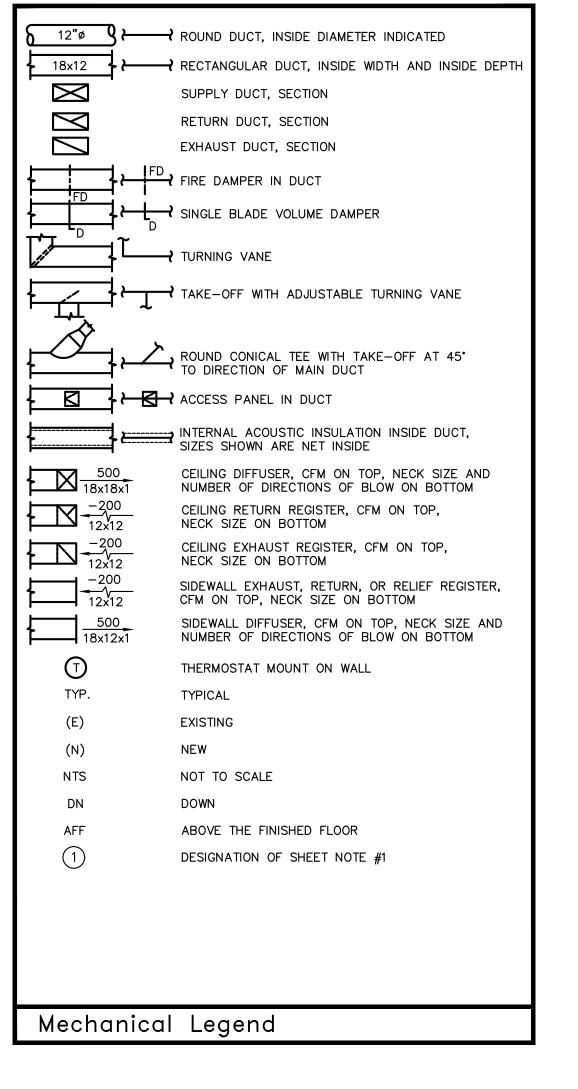

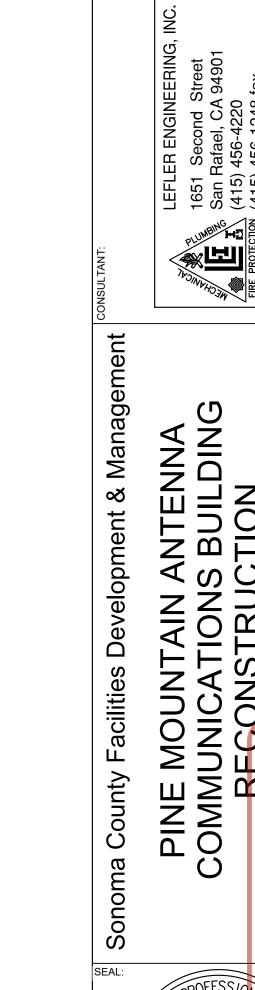

SHEET LOG
REV # DATE: ISSUED FOR WARD AND CONTROL OF CALL WARD AND CONT

JOB NUMBER:
SHEET:

M 1 1

MECHANICAL SCHEDULES AND LEGEND

ORIGINAL DATE: APRIL 30, 2024 © AXIA ARCHITECTS

/21/2024 11:10:29 AM C:\Users\Sratley\Documents\REVIT\1191 Pine Mtn Rd Comm Vault_C_sratleyS9ADW.rvt



Sheet Notes

- 1. INSTALL CONDENSING UNIT AT GRADE, SEE DETAIL 1/M1.1.
- 2. INSTALL FAN COIL UNIT ON WALL, SEE DETAIL 2/M1.1.
- 3. RUN REFRIGERANT PIPING SURFACE MOUNTED ON WALL AND CEILING TO CONNECT BETWEEN CONDENSING UNIT AND FAN COIL UNIT. PROVIDE ALUMINUM JACKETING FOR ALL REFRIGERANT PIPING OUTSIDE. TYPICAL.
- 4. RUN REFRIGERANT PIPING BELOW GRADE BETWEEN COMMUNICATIONS BUILDING AND CONDENSING UNITS. SEE DETAIL 3/M1.1.
- 5. INSTALL TEMPERATURE SENSOR ON WALL WIRED TO DDC CONTROLLER.
- 6. INSTALL DDC CONTROLLER ON WALL. SEE SPECIFICATIONS FOR DDC SEQUENCE OF OPERATIONS.

AMCHITEO

LEFLER ENGINEERING, INC.

1651 Second Street

San Rafael, CA 94901

(415) 456-1248 fax

IMUNICATIONS BUILDING
RECONSTRUCTION

SEAL:

PROFESSIONAL

Exp.

3-31-26

M 37725

ATTE OF CALIFOR

SHEET LOG

DATE: ISSUED FOR:

3/27/2024 50% CD Drawings
4/30/2024 100% CD Drawings
3/21/2025 Structural Wall Revisi

3/27/2024 50% CD Drawings
4/30/2024 100% CD Drawings
3/21/2025 Structural Wall Revisio

JOB NUMBER:

M2.1

MECHANICAL FLOOR PLAN

ORIGINAL DATE: APRIL 30, 2024 © AXIA ARCHITECTS



STATE OF CALIFORNIA

Mechanical Systems

CERTIFICATE OF COMPLIANCE

Registration Number:	Generated Date/Time:	Documentation Software: Energy Code Ace
CA Building Energy Efficiency Standards - 2019 Nonresidential Compliance	Report Version: 2019.1.003 Schema Version: rev 20200601	Compliance ID: 76385 Report Generated: 2022-10-27 14:00:49
STATE OF CALIFORNIA		
Mechanical Systems NRCC-MCH-E		CALIFORNIA ENERGY COMMISSION
CERTIFICATE OF COMPLIANCE		NRCC-MCH-E
Project Name: County of Sonoma Pine Mountain Antenna Comm	nunications Vault Report Page:	(Page 5 of 6)
Project Address: Pine Mountain Road, C	Cloverdale, CA Date Prepared:	2022-10-27T17:00:45-04:00
M. COOLING TOWERS		
This section does not apply to this project.		
This section does not apply to this project.		
N. DECLARATION OF REQUIRED CERTIFICATES OF INSTALLATION		
Selections have been made based on information provided in previous tables These documents must be provided to the building inspector during construct https://www.energy.ca.gov/title24/2019standards/2019_compliance_docum	tion and can be found online at	o be changed, please explain why in Table E Additional Remarks.
	Form/Title	
NRCI-MCH-01-E - Must be submitted for all buildings		
O. DECLARATION OF REQUIRED CERTIFICATES OF ACCEPTANCE		
There are no NRCA forms required for this project.		
P. DECLARATION OF REQUIRED CERTIFICATES OF VERIFICATION		
There are no NRCV forms required for this project.		
Q. MANDATORY MEASURES DOCUMENTATION LOCATION		
This table is used to indicate where mandatory measures are documented in	the plan set or construction documentation	on.
01		02
Compliance with Mandatory Measures documented through MCH Mandatory Measures Note Block	Yes	M1.1
Registration Number:	Generated Date/Time:	Documentation Software: Energy Code Ace
CA Building Energy Efficiency Standards - 2019 Nonresidential Compliance	Report Version: 2019.1.003 Schema Version: rev 20200601	Compliance ID: 76385 Report Generated: 2022-10-27 14:00:49

CALIFORNIA ENERGY COMMISSION

§110.2(e)2 Compliance Results

COMPLIES

(Page 2 of 6)

2022-10-27T17:00:45-04:00

Mechanical Systems

CERTIFICATE OF COMPLIANCE

C. COMPLIANCE RESULTS

D. EXCEPTIONAL CONDITIONS

E. ADDITIONAL REMARKS

§140.4(k)

(See Table G)

County of Sonoma Pine Mountain Antenna Communications Vault Report Page:

Controls

(See Table I)

Mandatory Measures Compliance (See Table Q for Details)

NOT COMPLY" or "COMPLIES with Exceptional Conditions" refer to Table D., or the table indicated as not compliant for guidance.

This table is auto-filled with uneditable comments because of selections made or data entered in tables throughout the form.

§140.4(c),

(See Table H)

This table includes remarks made by the permit applicant to the Authority Having Jurisdiction.

Pine Mountain Road, Cloverdale, CA Date Prepared:

Table C will indicate if the project data input into the compliance document is compliant with mechanical requirements. This table is not editable by the user. If this table says "DOES"

(See Table J)

Controls

§140.4(d)

(See Table K)

§120.3,

(See Table L) (See Table M)

Project Name:

Project Address:

Summary

§110.2,

§140.4

(See Table F)

CALIFORNIA ENERGY COMMISSION

CERTIFICATE OF CO	OMPLIANCE									ı	NRCC-MCH-
Project Name: County of Sonoma Pine Mountain Antenna Communications Vault Report Page: (Page 3 of											
Project Address:		Pine Mountain Road, Clove	erdale, CA	Date Prepar	ed:				20	22-10-27T17	:00:45-04:0
F. HVAC SYSTEN	л SUMMARY (DRY & WET	SYSTEMS)									
§140.4(b) and §1	<u>140.4(k)</u> or <u>§141.0(b)2</u> for a						<u>10.2(a)</u> and	l prescriptiv	e requireme	nts found in	<u>§140.4(a</u>
01	O2	onditioners, condensers, heat pump		04	05	06	07	08	09	10	11
	<u> </u>				0.5		nt Sizing pe		al Schedule		
S2000	1000 and 100							GOutput ^{2,3} Load Calcu		ulations ^{3,4}	
Name or Item Tag	Equipment Category per Tables 110.2	Equipment Type per Tables 110.2 / Title 20	Title Ava	ailable ¹ 10.4(a)	Per Design (kBtu/h)	Rated (kBtu/h)	Supp. Heating Output (kBtu/h)	Sensible Per Design (kBtu/h)	Rated (kBtu/h)	Total Heating Load (kBtu/h)	Total Sensible Cooling Load (kBtu/h)
HP-1, FC-1	Unitary Heat Pumps	Air-cooled, split (1phase)		Yes	25699	26000	0	29056	36000	12000	28000
HP-2, FC-2	Unitary Heat Pumps	Air-cooled, split (1phase)		Standby ipment	25699	26000	0	29056	36000	12000	28000
<u>§140.4(a)</u> . Health ² It is common pro ³ If equipment is I ⁴ Authority Havin	ncare facilities are excepted. actice to show rated output o heating only, leave cooling o g Jurisdiction may ask for loo	t size, within the available options of apacity on the equipment schedule utput and load blank. If equipment and calculations used for compliance	Sensible coo s cooling onl per <u>§140.4(b</u>	oling outpu y, leave he	nt comes fro eating outpu	m specificat it and load b	ion sheet to lank.		nd cooling lo	ads of the l	ouilding p
	, , , , , , , , , , , , , , , , , , , ,	n Package Terminal Air Conditioner	•					07 T	00		00
01	02 03 04 05 06 07 08 09										

01	02	03	04	05	06	07	08	09		
			Heati	ng Mode			Cooling Mode			
Name or Item Tag	Size Category (Btu/h)	Rating Condition (°F)	Efficiency Unit	Minimum Efficiency Required per Tables 110.2 / Title 20	Design Efficiency	Efficiency Unit	Minimum Efficiency Required per Tables 110.2 / Title 20	Design Efficiend		
HP-1, FC-1	<65,000		HSPF	8.19	9.19	SEER	14	18.8		
HP-2, FC-2	<65,000		HSPF	8.19	9.19	SEER	14	18.8		

Schema Version: rev 20200601 Report Generated: 2022-10-27 14:00:49 Mechanical Systems CALIFORNIA ENERGY COMMISSION CERTIFICATE OF COMPLIANCE NRCC-MCH-E County of Sonoma Pine Mountain Antenna Communications Vault Report Page

Report Version: 2019.1.003

		1		(
Project Address:	Pine Mountain Road, Cloverdale, CA	Date Prepared:		2022-10-27T17:00:45-04:00
DOCUMENTATION AUTHOR'S D	DECLARATION STATEMENT			
I certify that this Certificate of	Compliance documentation is accurate and comple	te.		
Documentation Author Name: Trevor Lefler		Documentation Author Signature:	Tun tefle	
Company: Lefler Engineering, Inc.		Signature Date: 10/27/22		
Address: 1651 2nd St		CEA/ HERS Certification Identification	(if applicable):	

RESPONSIBLE PERSON'S DECLARATION STATEMENT certify the following under penalty of perjury, under the laws of the State of California: The information provided on this Certificate of Compliance is true and correct.

ity/State/Zip: San Rafael, CA 94901

CA Building Energy Efficiency Standards - 2019 Nonresidential Compliance

I am eligible under Division 3 of the Business and Professions Code to accept responsibility for the building design or system design identified on this Certificate of Compliance (responsible designer) The energy features and performance specifications, materials, components, and manufactured devices for the building design or system design identified on this Certificate of Compliance conform to the requirement of Title 24, Part 1 and Part 6 of the California Code of Regulations.

Phone: 415-456-4220

The building design features or system design features identified on this Certificate of Compliance are consistent with the information provided on other applicable compliance documents, worksheets, calculations, plans and specifications submitted to the enforcement agency for approval with this building permit application. I will ensure that a completed signed copy of this Certificate of Compliance shall be made available with the building permit(s) issued for the building, and made available to the enforcement agency for all applicable inspections. I understand that a completed signed copy of this Certificate of Compliance is required to be included with the documentation the builder provides to the building owner at occupancy.

esponsible Designer Name: onsible Designer Signature: Trevor Lefler Date Signed: 10/27/22 Company: Lefler Engineering, Inc. Address: 1651 2nd St icense: 37725 ity/State/Zip: San Rafael, CA 94901 Phone: 415-456-4220

Generated Date/Time: Registration Number: Documentation Software: Energy Code Ace CA Building Energy Efficiency Standards - 2019 Nonresidential Compliance Report Version: 2019.1.003 Compliance ID: 76385 Schema Version: rev 20200601 Report Generated: 2022-10-27 14:00:49

. Manager

County

Compliance ID: 76385

SHEET LOG 1/04/22 PERMIT

3/27/2024 50% CD Drawings 4/30/2024 100% CD Drawings 3/21/2025 Structural Wall Revision

JOB NUMBER:

TITLE 24

ORIGINAL DATE: APRIL 30, 2024 © AXIA ARCHITECTS

ELECTRICAL LEGEND

ABBREVIATIONS

ABOVE FINISHED FLOOR

EXISTING

(N)

UNLESS OTHERWISE NOTED

AMPS

CONDUIT

GROUND

VOLTS

WEATHER PROOF

DEVICES

 \Rightarrow DUPLEX RECEPTACLE 125V, 20A, 3PG, +18" A.F.F. U.O.N.

QUADPLEX RECEPTACLE 125V, 20A, 3PG, +18" A.F.F. U.O.N.

DUPLEX GFCI RECEPTACLE 125V, 20A, 3PG, +18" A.F.F. U.O.N.

DUPLEX CONTROLLED RECEPTACLE 125V, 15A, 3PG,

+18" A.F.F. U.O.N.

 \rightarrow SINGLE RECEPTACLE SEE PLANS FOR TYPE



DATA/VOICE OUTLET +18" A.F.F

LIGHTING

⟨F ⁻	1	LIGHTING	FIXTURE	TAG	_	SEE	FIXTURE	SCHEDUL	_E
	_/								

1' X 4' SURFACE LIGHT FIXTURE

OUTDOOR WALL MOUNT FIXTURE

EMERGENCY LIGHT WITH 90 MINUTE BATTERY BACK-UP

LIGHTING DEVICES

TOGGLE SWITCH 120V, 15A, 1 POLE +48" A.F.F. TO TOP OF BOX

D DIMMER SWITCH +48" A.F.F. TO TOP OF BOX


OS OCCUPANCY SENSOR— WALL MOUNT +48" A.F.F. TO TOP OF BOX

03 OCCUPANCY SENSOR- CEILING MOUNT

POWER PACK

TYPE	DESCRIPTION	MANUFACTURER	CATALOG NUMBER	DRIVER	LAMP(S)	WATTS	VOLTAGE
F1	2' LED STRIP LIGHT WITH LENS	LITHONIA	CSS L24 AL015 MVOLT SWW3 80CRI	0-10V	LED- 3500K COLOR SELECTABLE	13	120V
F2	OUTDOOR LED SECURITY LIGHT 2-HEAD SURFACE MOUNT WITH MOTION SENSOR DUSK TO DAWN	SANSI OR EQUAL	32W		LED— 5000K 3600 LUMENS	36	120V

1 LIGHTING FIXTURE SCHEDULE

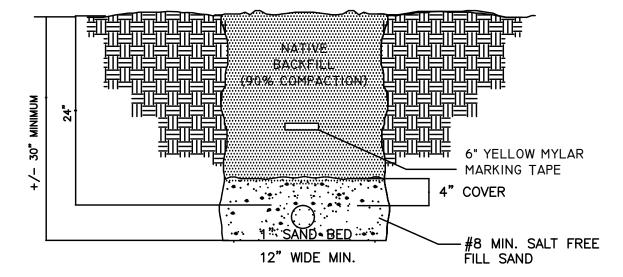

NDTES:

1. ELECTRIC CONDUIT (UL APPROVED) PVC SCHEDULE 40.

2. USE PVC SCHEDULE 80 AT EXPOSED ABOVEGROUND 90 DEGREE STUB-UP LOCATIONS.

TRENCH DETAIL SCALE: NONE

POWER DISTRIBUTION

SURFACE MOUNTED ELECTRICAL PANEL 6'-6" TO TOP

FLUSH MOUNTED ELECTRICAL PANEL 6'-6" TO TOP

FUSED SAFETY SWITCH

TRANSFORMER

HEAVY DUTY. VOLTAGE AND FUSE SIZE CALLED OUT ON PLANS NON-FUSED SAFETY SWITCH

HEAVY DUTY 120V, 15A, 1P TOGGLE SWITCH

TIME CLOCK

HVAC AND PLUMBING

MECHANICAL EQUIPMENT TAG- SEE MECHANICAL DRAWINGS

PLUMBING EQUIPMENT TAG- SEE PLUMBING DRAWINGS

EXHAUST FAN

THERMOSTAT BY MECHANICAL

CONDUIT ABOVEGROUND CONDUIT

UNDERGROUND CONDUIT

4-11/16" SQUARE TYPE JUNCTION BOX WITH BLANK COVER PLATE

CONDUIT HOMERUN TO PANELBOARD

WIRING IDENTIFICATION

[\]— GROUND

ELECTRICAL DRAWING LIST

EO.1 ELECTRICAL COVER SHEET AND DETAILS

E1.0 ELECTRICAL SITE PLAN

E2.0 ELECTRICAL DEMOLITION PLANS

E3.0 ELECTRICAL NEW PLANS

E4.0 ONE LINE DIAGRAM AND PANEL SCHEDULE

E5.0 TITLE 24 INDOOR LIGHTING

E6.0 TITLE 24 OUTDOOR LIGHTING

GENERAL NOTES:

OTHERWISE NOTED.

INDICATED ON DRAWING.

ENNA

PIN

POWER CIRCUITS, BRANCH CIRCUITS & HOMERUNS (UNLESS OTHERWISE NOTED). 4. RECEPTACLES AND SWITCHES INTENDED TO BE USED BY OCCUPANT SHALL HAVE A LOW REACH OF 15" MEASURED TO THE BOTTOM OF THE OUTLET BOX AND

1. ALL DEVICES AND EQUIPMENT SHOWN ARE NEW UNLESS

EQUIPMENT. IT ALSO INDICATES THE CIRCUIT NUMBER AND PANEL DESIGNATION WHICH SUPPLIES THEM. THE

CONTRACTOR SHALL BE RESPONSIBLE FOR COMPLETELY

CONNECTING ALL ELECTRICAL DEVICES TO THE CIRCUITS

GREEN COPPER THHN GROUNDING CONDUCTOR IN ALL

2. DRAWINGS INDICATES THE LOCATION OF DEVICES &

3. CONTRACTOR SHALL PROVIDE & INSTALL A #12 AWG

THE OUTLET BOX. CBC 11B-308. 5. CONTRACTOR SHALL COORDINATE WITH ANY OTHER APPROPRIATE TRADES PRIOR TO INSTALLATION OF ANY BOXES OR CONDUIT IN ORDER TO AVOID ANY

THE HIGH REACH OF 48" MEASURED TO THE TOP OF

CONFLICTING INSTALLATIONS.

6. PROVIDE PULL LINE IN ALL SPARE CONDUITS AND IN CONDUITS DESIGNATED AS CONDUIT ONLY.

7. CONDUIT ROUTING SHOWN IS APPROXIMATE EXACT ROUTING TO BE DETERMINED IN FIELD.

8. ALL NEW CABLES ARE THHN/THWN COPPER.

9. ALL ELECTRICAL WORK SHALL COMPLY TO CBC 2022, CEC 2022, AND NEC 2022.

10. PROVIDE SUBMITTALS ON LIGHT FIXTURES AND ELECTRICAL PANELS FOR APPROVAL WITHIN 30 DAYS OF STARTING WORK.


11. AT THE COMPLETION OF THE PROJECT PROVIDE COPIES OF THE NONRESIDENTIAL CERTIFICATES (NRCA) FOR NEW LIGHTING SYSTEMS TO THE BUILDING DEPARTMENT. THESE FORMS ARE CONFIRMATION THE CONTROLS HAVE BEEN TESTED AND ARE WORKING PROPERLY. THE TESTING OF THE CONTROLS SYSTEMS AND THE COMPLETION OF THE NRCA FORMS MUST BE DONE BY A THIRD PARTY INSPECTOR.

12. ANOTHER FORM THE BUILDING DEPARTMENT MAY REQUEST FOR THE LIGHTING SYSTEM IS THE NONRESIDENTAIL CERTIFICATE OF INSTALLATION (NRCL) WHICH CAN BE COMPLETED BY THE INSTALLING CONTRACTOR.

D PROFESSIONAL 06.05.24 S/MICHAEL JOHNSTON 🔏 NO. E 15586 ★ EXP. 12–31–25 Mike Johnston SHEET LOG REV # DATE: ISSUED FOR: JOB NUMBER:

E0.1

ELECTRICAL COVER SHEET AND DETAILS

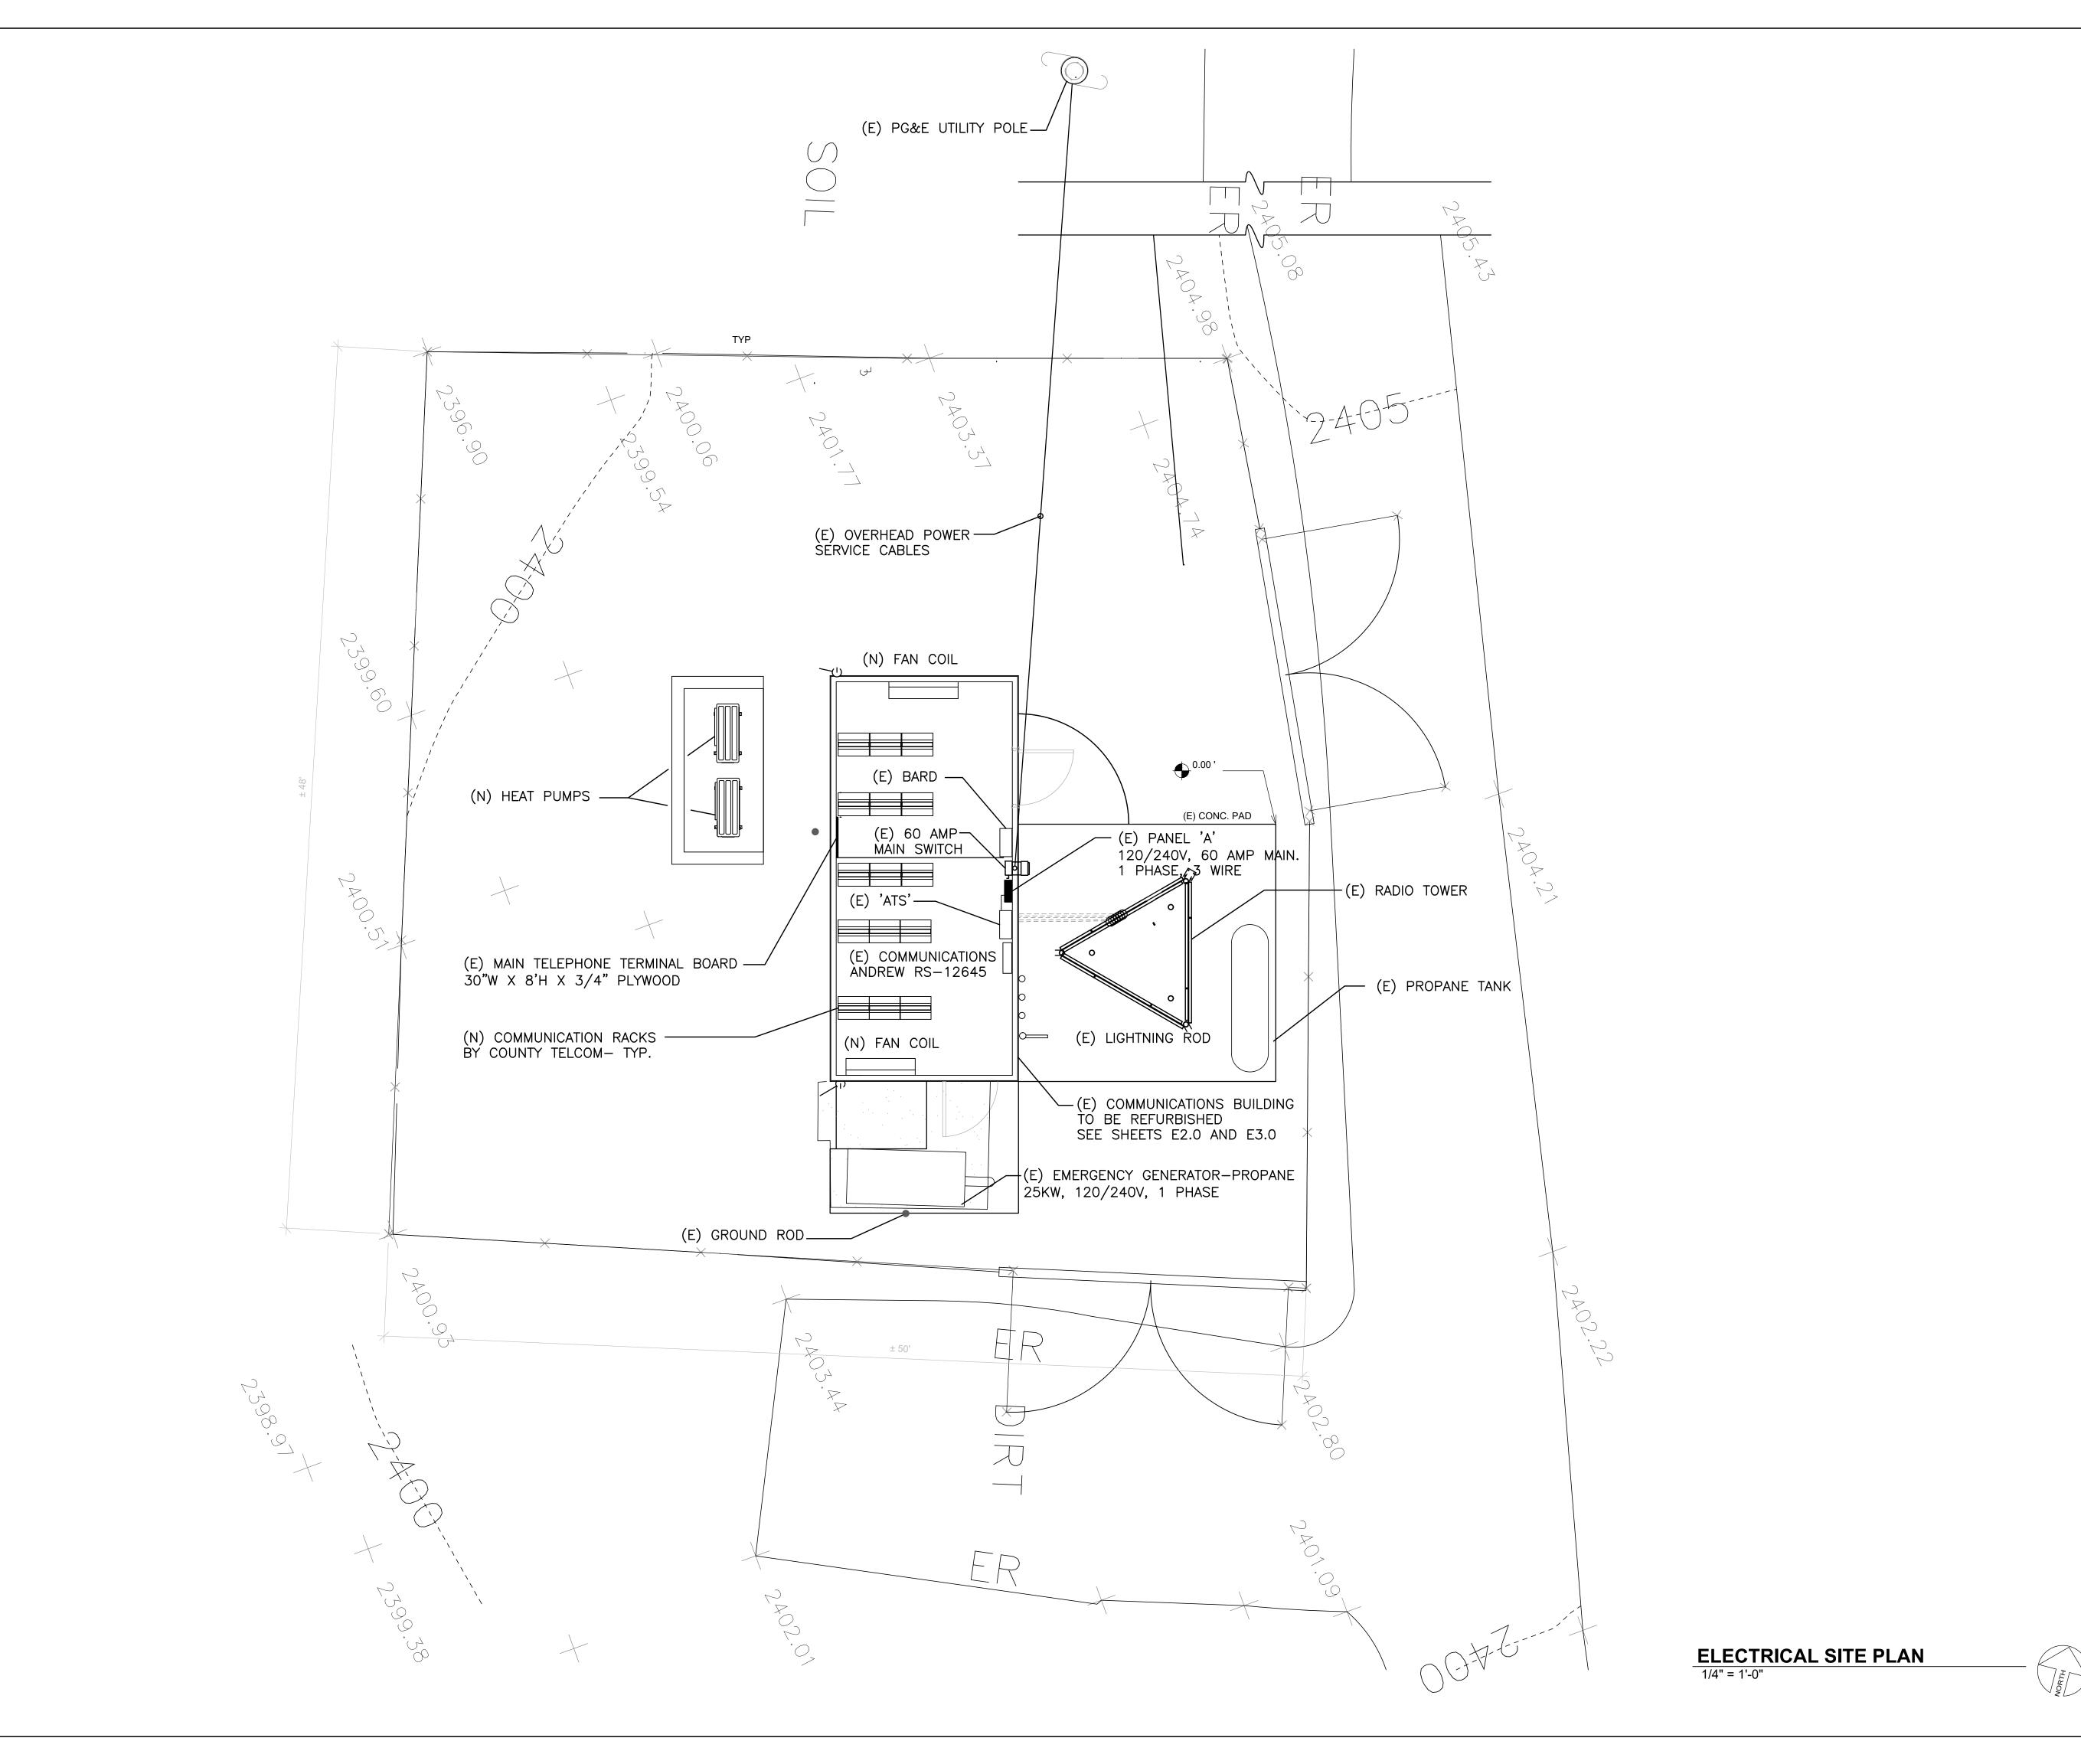

ARCHITECT:

ARCHITECTS

ARCHITECTS

540 Mendocino Ave, Santa Rosa, CA 95401

Engineering Enterprises Inc Electrical Engineering and Designs 613 4th Street Suite 206b Santa Rosa, Ca. 95404 (707) 544-7775

PINE MOUNTAIN ANTENNA COMMUNICATIONS BUILDING RECONSTRUCTION

SEAL:

O6.04.24

O6.04.24

MICHAEL JOHNSTON

NO. E 15586


EXP. 12-31-25

SHEET LOG
REV # DATE: ISSUED FOR:

Date Stamped: 4/7/2025 Permit #: Bl

JOB NUMBER:

E1.0
ELECTRICAL SITE PLAN

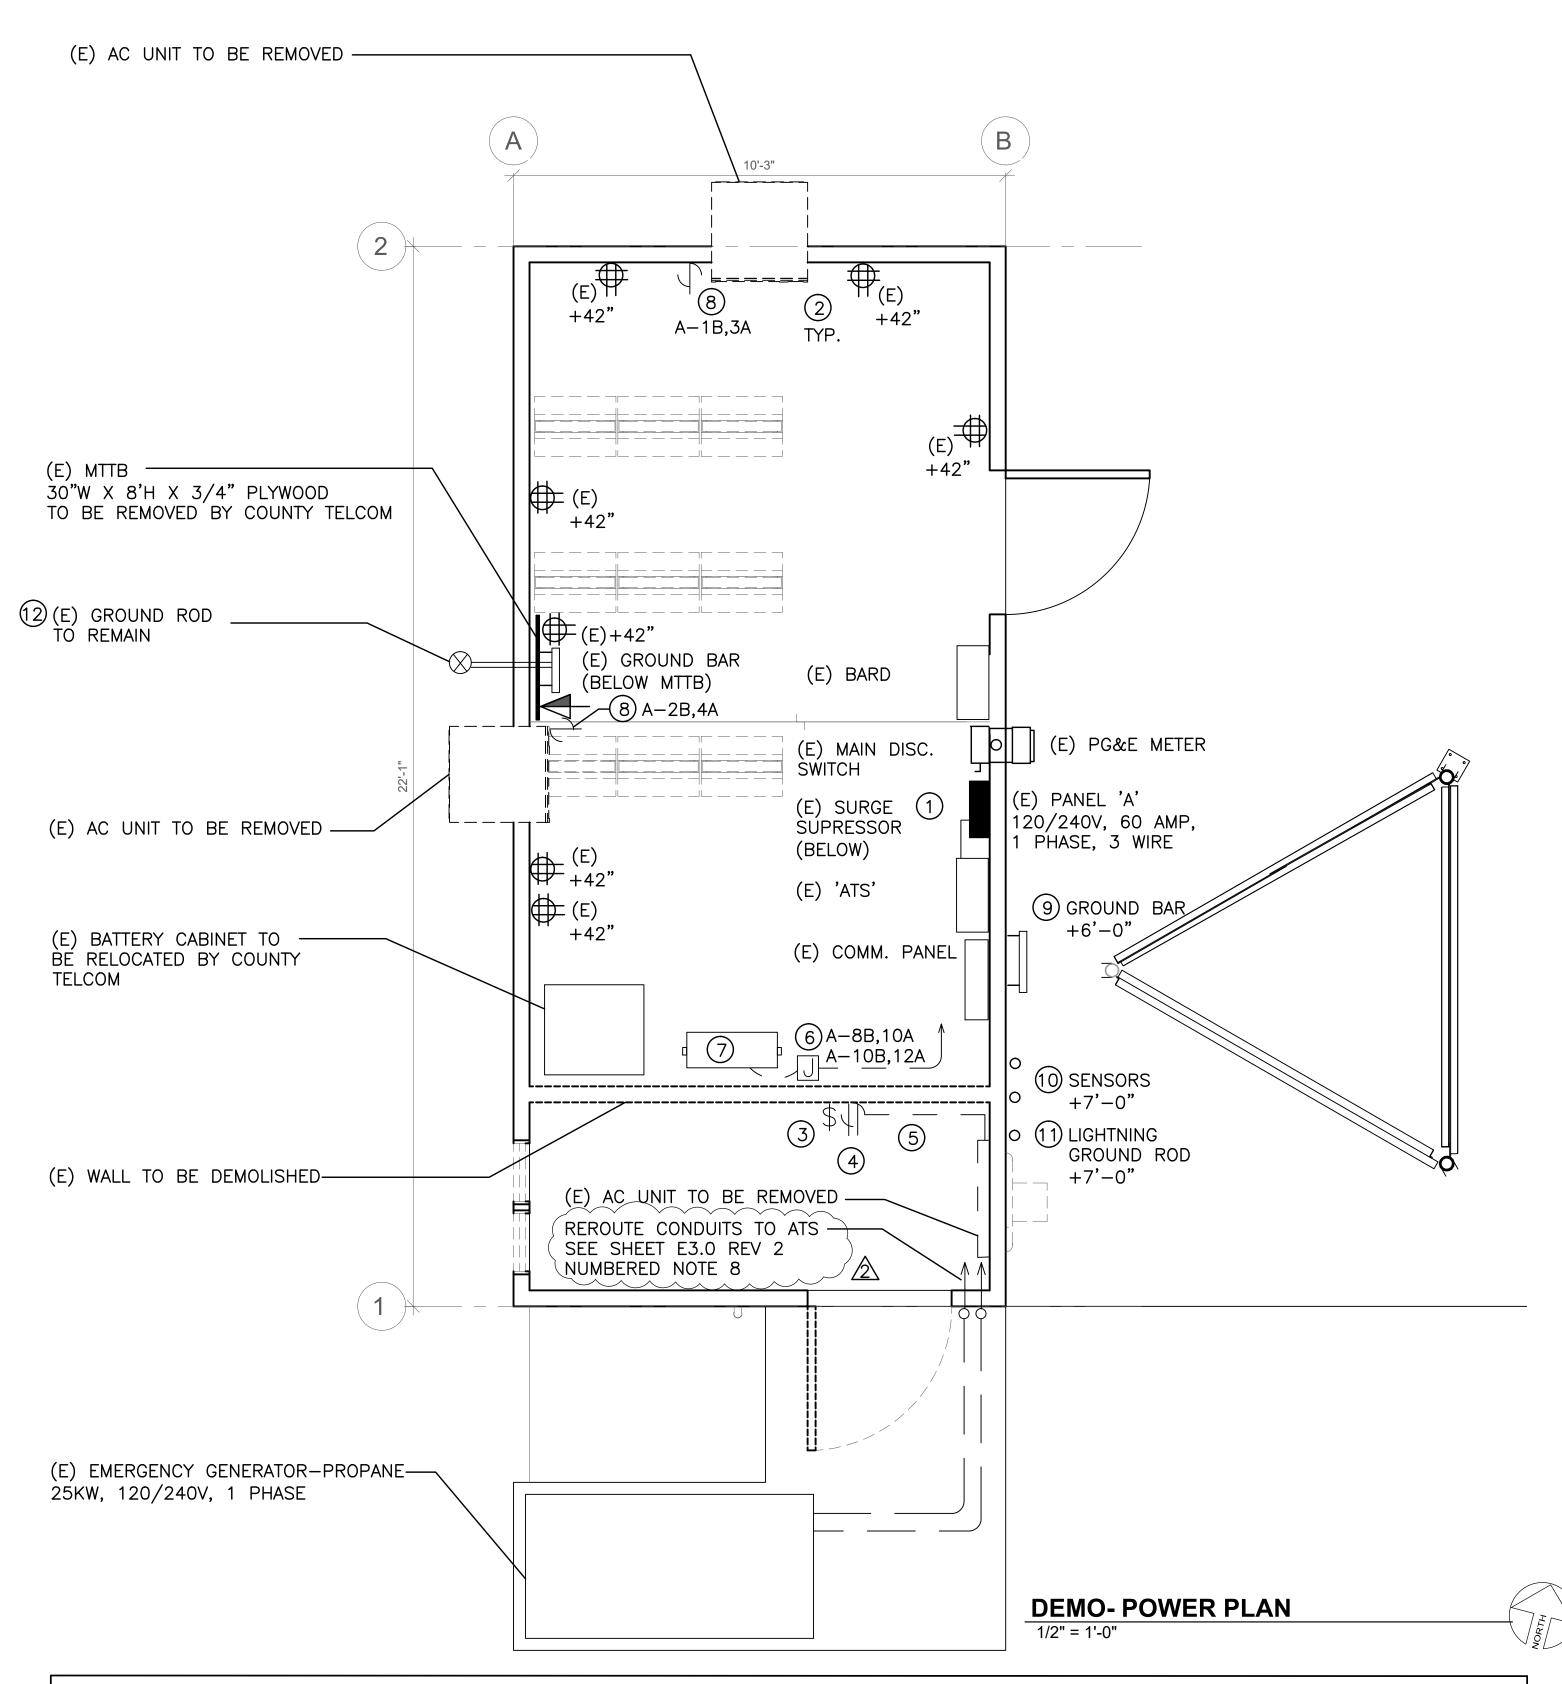


NUMBERED NOTES:

- 1) COVER AND PROTECT (E) PANELS AND EQUIPMENT ON WALL. BUILDING INTERIOR AND EXTERIOR SHALL BE REMODELED/REFURBISHED. SEE ARCHITECTURAL DRAWINGS.
- 2 COVER AND PROTECT (E) OUTLETS.
- 3 REMOVE (E) SWITCH.
- 4 REMOVE (E) OUTLET
- 5) REMOVE (E) CONDUIT.
- 6 DISCONNECT AND REMOVE (E) CONDUIT AND CABLES TO (E) 48 VOLT CHARGER. DISCONNECT AND REMOVE CABLES AT PANEL 'A'.
- (E) 48 VOLT CHARGERS TO BE RELOCATED BY COUNTY TELCOM.
- 8 REMOVE (E) OUTLET FOR AC UNIT. DISCONNECT AND REMOVE (E) CIRCUIT AT PANEL 'A'

- 9 TEMPORARILY REMOVE GROUND BAR FROM BUILDING. REMOUNT GROUND BAR AFTER RESTORATION WORK IS COMPLETE. PROVIDE (N) MOUNTING HARDWARE AS REQUIRED.
- (10) TEMPORARILY REMOVE SENSORS FROM BUILDING. REMOUNT SENSORS AFTER RESTORATION WORK IS COMPLETE. PROVIDE (N) MOUNTING HARDWARE AS REQUIRED.
- 11) TEMPORARILY REMOVE LIGHTNING GROUND ROD FROM BUILDING. REMOUNT SENSORS AFTER RESTORATION WORK IS COMPLETE. PROVIDE (N) MOUNTING HARDWARE AS REQUIRED.
- 12) PRESERVE AND PROTECT GROUND CABLES FROM GROUND BAR IN ROOM.

GENERAL NOTES:

- 1. REFER TO ARCHITECTURAL DRAWINGS FOR PHASING OF WORK.
- 2. COUNTY TELCOM GROUP SHALL BE RESPONSIBLE FOR ALL EXTERIOR AND INTERIOR COMMUNICATION CABLES, LOW VOLTAGE CABLES, CABLE TRAY, BATTERY CABINET, AND COMMUNICATION RACKS.

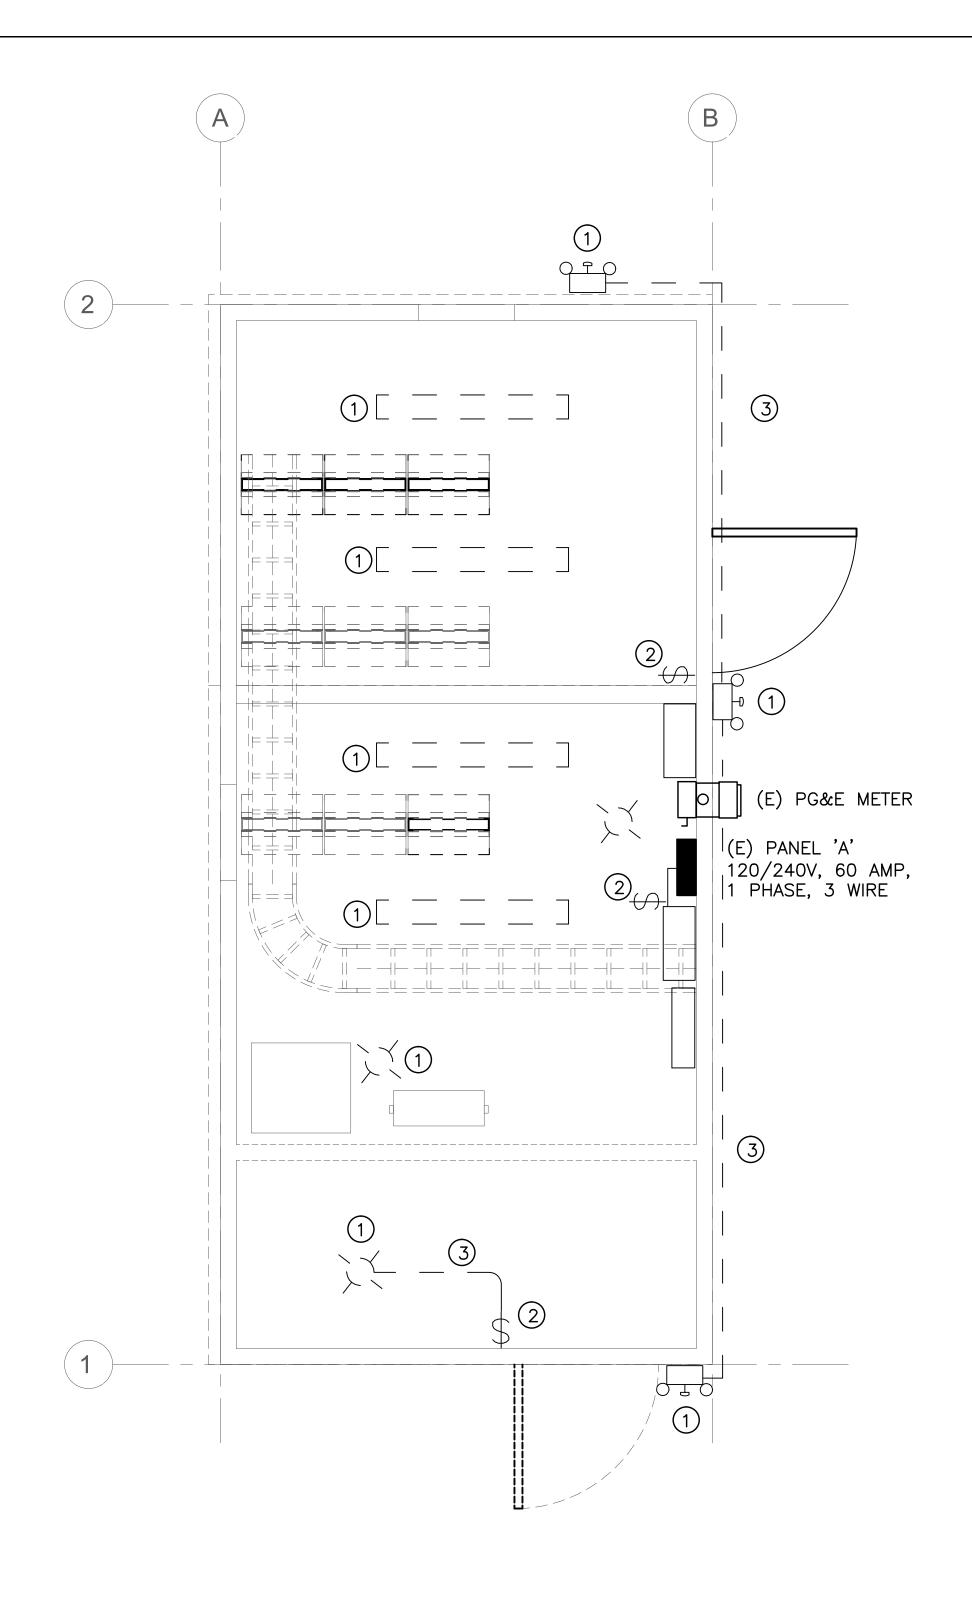

DEMO-LIGHTING PLAN

- 1) REMOVE (E) LIGHT FIXTURE
- 2 REMOVE (E) LIGHT SWITCH.
- 3 REMOVE (E) CONDUIT.

NUMBERED NOTES:




Wike Johnston REV# DATE: ISSUED FOR: JOB NUMBER: **E2.0**

O6.05.24

MICHAEL JOHNSTON
NO. E 15586

🗼 EXP. 12–31–25 🏒



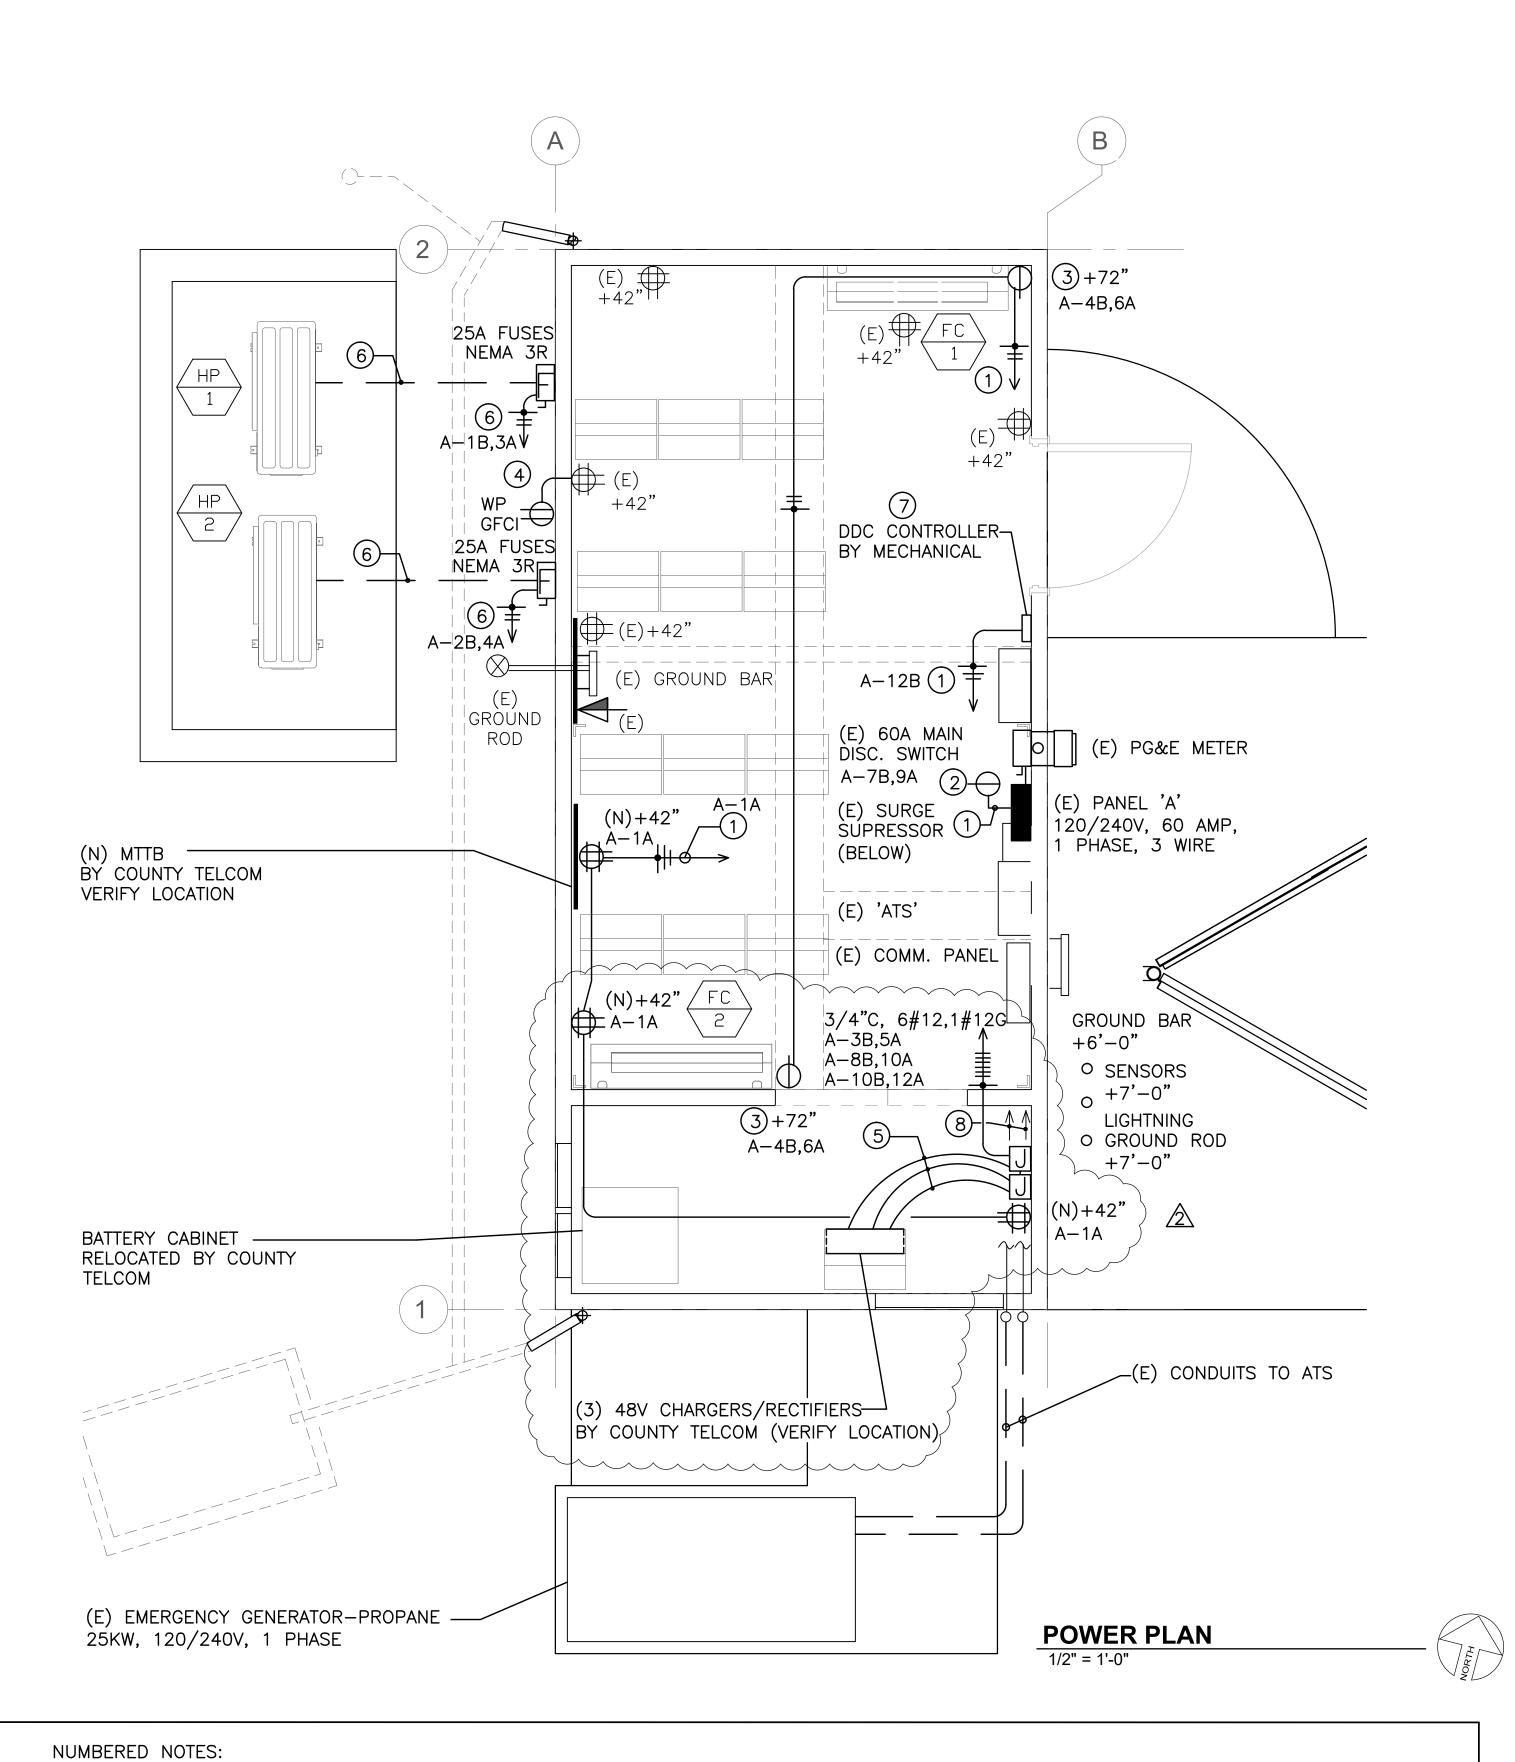

(8) REROUTE (E) INTERIOR CONDUITS FROM GENERATOR AROUND (N)

1-1/2°C, 3#2, 1#8G (POWER TO ATS)

3/4°C, 3/C #18 (CONTROL TO ATS)

STRUCTURAL COLUMN. REMOVE (E) CABLING AND REPLACE WITH NEW. ASSUME THE FOLLOWING CONDUITS AND CABLES. VERIFY IN FIELD.

2#12, 1#12 (POWER TO BATTERY CHARGER FROM PANEL 'A')

(1) 3/4"C, 2#12, 1#12G

 \bigcirc (N) 20A, 250V, NEMA 6-20R SINGLE RECEPTACLE FOR USE BY COUNTY TELCOM DURING REMODEL.

(N) 15A, 250V, NEMA 6-15R SINGLE RECEPTACLE. COORDINATE LOCATION OF OUTLET WITH MECHANICAL.

(4) CONNECT TO (E) 120V RECEPTACLE CIRCUIT IN BUILDING. PROVIDE (N) 3/4°C, $2\mathring{1}$ 1, 1#12G TO (N) WP GFCI OUTLET OUTLET.

(3) 3/4"C, 2#12, 1#12G FLEXIBLE METALLIC CONDUITS. CONNECT 240V, 20 AMP CIRCUIT TO EACH 48 VOLT CHARGER/RECTIFIER.

6 3/4°C, 2#10, 1+10G

(7) LOCATE ON WALL IN AVAILABLE SPACE.

10 TOTAL 4 TOTAL A-11B(a) 2)-TYP. A-11B(a) A-11B(a) A−11B(a) ‡ A-11B(a) $A-11B(a)^{-}$ A-11B(a) A-11B(b)LIGHTING PLAN 1/2" = 1'-0"


NUMBERED NOTES:

- 1) 3/4"C, 2#12, 1#12G.
- ② MC LUMINARY CABLE AFC-42-504 16-2, 12-2, 12G
- \bigcirc 0-10V DIMMER SWITCH LUTRON DIVA DVSTV.

A-11B(b) <u>-979</u> 2 (E) PG&E METER (E) PANEL 'A' 120/240V, 60 AMP, 1 PHASE, 3 WIRE



PINE MOUNTAIN ANTENNA COMMUNICATIONS BUILDING RECONSTRUCTION 03.21.25 MICHAEL JOHNSTON NO. E 15586 EXP. 12−31−25 Mike Johnston or SHEET LOG RESUBMITTAL JOB NUMBER: **E3.0** ELECTRICAL NEW PLANS ORIGINAL DATE: JUNE 7, 2024 © AXIA ARCHITECTS

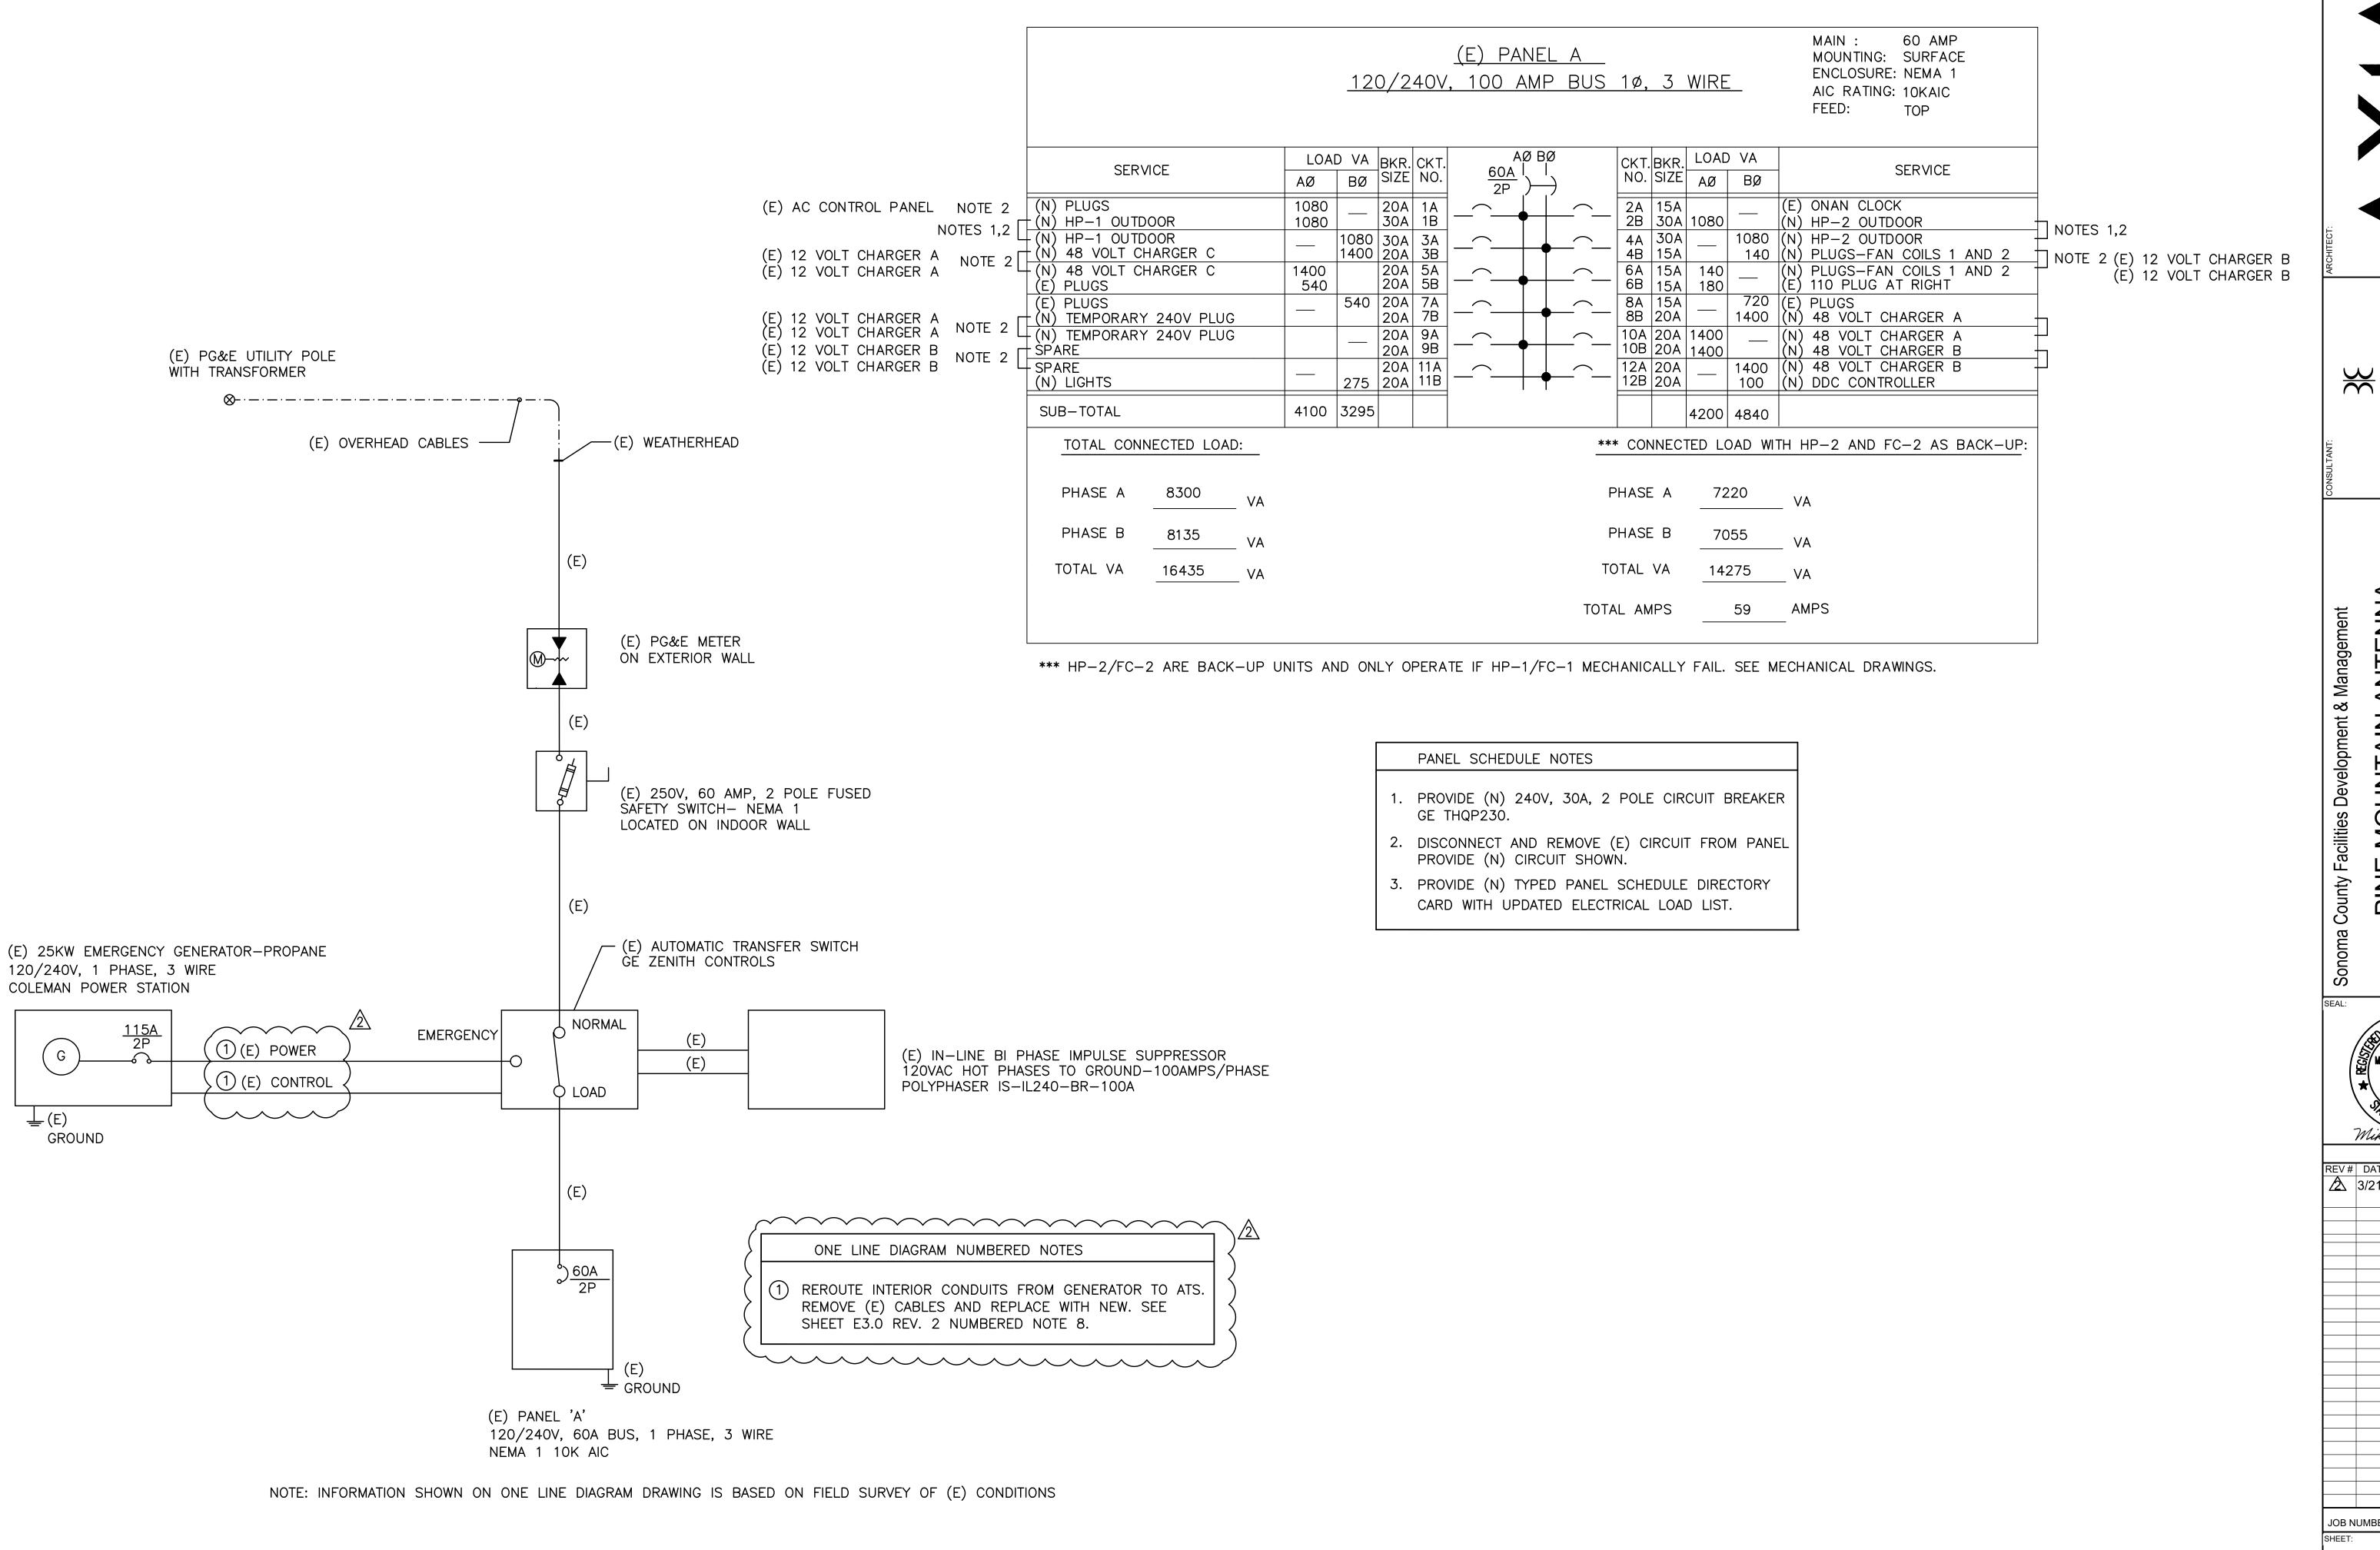

(E) ONE LINE DIAGRAM

Engin Electric

I ANTENNA IS BUILDING JCTION

PINE MOUNTAIN A COMMUNICATIONS RECONSTRUC

MICHAEL JOHNSTON NO. E 15586 ★ EXP. 12-31-25

REV # DATE: ISSUED FOR: RESUBMITTAL

JOB NUMBER:

E4.0 ONE LINE DIAGRAM AND PANEL SCHEDULE

STATE OF CALIFORNIA	STATE OF CALIFORNIA	STATE OF CALIFORNIA	
Indoor Lighting	Indoor Lighting	Indoor Lighting	CALIFORNIA ENERGY COMMISSION
NRCC-LTI-E CALIFORNIA ENERGY COMMISSION CERTIFICATE OF COMPLIANCE NRCC-LTI-E	NRCC-LTI-E CALIFORNIA ENERGY COMMISSION CERTIFICATE OF COMPLIANCE NRCC-LTI-E	NRCC-LTI-E CERTIFICATE OF COMPLIANCE	CALIFORNIA ENERGY COMMISSION NRCC-LTI-E
This document is used to demonstrate compliance with requirements in §110.9, §110.12(c), §130.0, §130.1, §140.6 and §141.0(b)2 for indoor lighting scopes using the prescriptive	Project Name: Pine Mountain Communications Vault Report Page: (Page 2 of 7)		unications Vault Report Page: (Page 3 of 7)
path.	Project Address: Pine Mountain Road Date Prepared: 4/26/2024	Project Address: Pine	Mountain Road Date Prepared: 4/26/2024
Project Name: Pine Mountain Communications Vault Report Page: (Page 1 of 7) Project Address: Pine Mountain Road Date Prepared: 4/26/2024			
Project Address: Pine Mountain Road Date Prepared: 4/26/2024	C. COMPLIANCE RESULTS	H. INDOOR LIGHTING CONTROLS (Not including PAFs)	
A. GENERAL INFORMATION	Controls Compliance (See Table H for Details) COMPLIES	This table includes lighting controls for conditioned and unconditioned spaces.	. When a control having a * is shown, the notes section of this table provides more detail on how nary Table on the first page will show "DOES NOT COMPLY" if the notes are left blank.
01 Project Location (city) Cloverdale 04 Total Conditioned Floor Area (ft²) 226	Rated Power Reduction Compliance (See Table Q for Details)	Building Level Controls	ary ruble on the first page will show Does Not colviner if the notes are left blank.
02 Climate Zone 2 05 Total Unconditioned Floor Area (ft²) 0	D. EXCEPTIONAL CONDITIONS	01	02 03
03 Occupancy Types Within Project (select all that apply): 06 # of Stories (Habitable Above Grade) 1	This table is auto-filled with uneditable comments because of selections made or data entered in tables throughout the form.	Mandatory Demand Response §110.12(c)	Shut-off controls §130.1(c) Field Inspector
• : See Table I	E. ADDITIONAL REMARKS	Not Required <= 10,000 SF	Pass Fail See Area/Space Level Controls
B. PROJECT SCOPE	This table includes remarks made by the permit applicant to the Authority Having Jurisdiction.	Area Level Controls	See Area/space Level Controls
This table includes any lighting systems that are within the scope of the permit application and are demonstrating compliance using the prescriptive path outlined in §140.6 or		04 05 06	07 08 09 10 11 12
§141.0(b)2 for alterations.	F. INDOOR LIGHTING FIXTURE SCHEDULE		Primary/Sky
Scope of Work Conditioned Spaces Unconditioned Spaces	This table includes all permanent designed lighting and all portable lighting in offices.	Area Description Complete Building or Area Area Control Category Primary Function Area Control S120 1(a)	Multi-Level Shut-Off Controls State Controls Shut-Off Controls State Control State Controls State Controls State Control State
01 02 03 04 05 My Project Consists of (check all that apply): Calculation Method Area (ft²) Calculation Method Area (ft²)	Designed Wattage: Conditioned Spaces 01 02 03 04 05 06 07 08 09 10	Area Description Category Finnary Function §130.1(a)	\[\frac{\xi_{130.1(c)}}{\xi_{130.1(d)}} \] \[\frac{\xi_{130.1(d)}}{\xi_{130.1(d)}} \] \[\frac{\xi_{130.1(d)}}{\xi_{140.6(d)}} \] \[\frac{\xi_{140.6(a)1}}{\xi_{140.6(a)1}} \]
New Lighting System Area Category Method Area Category Method O	Small Eigld Increator		Pass Fail
□ New Lighting System - Parking Garage	Name or Item Complete Luminaire Modular Aperture & Watts per How is Wattage Total Number Excluded per Design Watts Tag Description Cirack) Fixture Aperture & Luminaire General Section Design Watts D	Electrical, Mechanical, Electrical Mechancial Manual Telephone Room Telephone Room ON/OFF	
Total Area of Work (ft²) 226 0	Tag Description (Track) Fixture Color Change ¹ Tuminaire determined of Luminaires 9,140.6(4)5 Pass Fail	*NOTES: Controls with a * require a note in the space below explaining how co	
C. COMPLIANCE RESULTS	F1 2' linear 13w LED No No 13 Mfr. Spec 10 No 130 □ □	EX: Conference 1: Primary/Skylight Daylighting: Exempt because less than 120	
If any cell on this table says "DOES NOT COMPLY" or "COMPLIES with Exceptional Conditions" refer to Table D. for guidance.	Total Designed Watts: CONDITIONED SPACES 130	to <u>\$130.1(d)2</u>	Than sheet showing buyint zones.
Allowed Lighting Power per §140.6(b) (Watts) Adjusted Lighting Power per §140.6(a) (Watts) Compliance Results	¹ FOOTNOTE: Design Watts for small aperture and color changing luminaires which qualify per §140.6(a)4B is adjusted to be 75% of their rated wattage. Table F automatically makes	Electrical, Mechanical, Telephone Room 130.1(c) Ex 4	E3.0
Lighting in 01 02 03 04 05 06 07 08 09	this adjustment, the permit applicant should enter full rated wattage in column 05.		<u> </u>
conditioned and unconditioned Area Adjustments	² Authority Having Jurisdiction may ask for Luminaire cut sheets to confirm wattage used for compliance per §130.0(c) Wattage used must be the maximum rated for the luminaire, not the lamp.	I. LIGHTING POWER ALLOWANCE: COMPLETE BUILDING OR AREA CAT	
spaces must not be Complete Area Category Tailored ≥ Total PAF Lighting Total Adjusted		Each area complying using the Complete Building or Area Category Methods p \$140.6(c) or adjustments per \$140.6(a) are being used.	per <u>§140.6(b)</u> are included in this table. Column 06 indicates if additional lighting power allowances per
Building Category Additional §140.6(c)3 = Designed Control Credits = (Watts) 05 must be >= 08	G. MODULAR LIGHTING SYSTEMS	Conditioned Spaces	
$\begin{array}{ c c c c c c c c c c c c c c c c c c c$			
$\begin{array}{c ccccccccccccccccccccccccccccccccccc$	This section does not apply to this project.	01 02	03 04 05 06
combined for compliance per §140.6(c)1 Building 5140.6(c)2 Category §140.6(c)2 Additional §140.6(c)3 \$140.6(c)3 Allowed (Watts) Control Credits §140.6(a)2 (Watts) Place (Watts) Control Credits §140.6(a)2 *Includes Adjustments (See Table I) (See Table I) (See Table I) (See Table I) (See Table II) (See Table III) (See Table IIII) (See Table IIIIIIIIIIIIIIIIIIIIIIIIIIIIIIIIIIII	This section does not apply to this project.	Area Description Complete Building or Area Category F	
$\begin{array}{c ccccccccccccccccccccccccccccccccccc$	This section does not apply to this project.	Complete Building or Area Category F	Primary Allowed Density (W/ft²) Area (ft²) Allowed Wattage (Watts) Area Category PAF
combined for compliance per \$140.6(c)1 Sidu.6(c)2 Additional \$140.6(c)2	STATE OF CALIFORNIA	Area Description Complete Building or Area Category Function Area STATE OF CALIFORNIA	Λroa (ft²)
combined for compliance per \$140.6(c)1 Suilding \$140.6(c)2 Category (H) Additional \$140.6(c)3 \$140.6(c)2 \$140.6(c)2 </th <th>STATE OF CALIFORNIA Indoor Lighting NRCC-LTI-E CALIFORNIA ENERGY COMMISSION</th> <th>Area Description Complete Building or Area Category Function Area STATE OF CALIFORNIA Indoor Lighting NRCC-LITI-E</th> <th>(W/ft²) Area (ft²) (Watts) Area Category PAF CALIFORNIA ENERGY COMMISSION</th>	STATE OF CALIFORNIA Indoor Lighting NRCC-LTI-E CALIFORNIA ENERGY COMMISSION	Area Description Complete Building or Area Category Function Area STATE OF CALIFORNIA Indoor Lighting NRCC-LITI-E	(W/ft²) Area (ft²) (Watts) Area Category PAF CALIFORNIA ENERGY COMMISSION
combined for compliance per \$140.6(c)1 Building \$140.6(c)2 Additional \$140.6(c)2 \$140.6(c)2 <th>STATE OF CALIFORNIA Indoor Lighting NRCC-LTI-E CALIFORNIA ENERGY COMMISSION CERTIFICATE OF COMPLIANCE NRCC-LTI-E</th> <th>Area Description Complete Building or Area Category Function Area STATE OF CALIFORNIA Indoor Lighting NRCC-LTI-E CERTIFICATE OF COMPLIANCE</th> <th>(W/ft²) Area (ft²) (Watts) Area Category PAF CALIFORNIA ENERGY COMMISSION NRCC-LTI-F</th>	STATE OF CALIFORNIA Indoor Lighting NRCC-LTI-E CALIFORNIA ENERGY COMMISSION CERTIFICATE OF COMPLIANCE NRCC-LTI-E	Area Description Complete Building or Area Category Function Area STATE OF CALIFORNIA Indoor Lighting NRCC-LTI-E CERTIFICATE OF COMPLIANCE	(W/ft²) Area (ft²) (Watts) Area Category PAF CALIFORNIA ENERGY COMMISSION NRCC-LTI-F
combined for compliance per \$140.6(b)1 Side Table I) (See Table II) (See Table II) (See Table III) (See Table IIII) (See Table IIIIIIIIIIIIIIIIIIIIIIIIIIIIIIIIIIII	STATE OF CALIFORNIA Indoor Lighting NRCC-LTI-E CALIFORNIA ENERGY COMMISSION CERTIFICATE OF COMPLIANCE Project Name: Pine Mountain Communications Vault Report Page: (Page 5 of 7)	Area Description Complete Building or Area Category Function Area STATE OF CALIFORNIA Indoor Lighting NRCC-LTI-E CERTIFICATE OF COMPLIANCE Project Name: Pine Mountain Communications Pine Mountain Communications Project Name:	(W/ft²) Area (ft²) (Watts) Area Category PAF CALIFORNIA ENERGY COMMISSION NRCC-LTI-E
combined for compliance per \$140.6(c)1 Building \$140.6(c)2 Additional \$140.6(c)2 \$140.6(c)2 <th>STATE OF CALIFORNIA Indoor Lighting NRCC-LTI-E CALIFORNIA ENERGY COMMISSION CERTIFICATE OF COMPLIANCE NRCC-LTI-E</th> <th>Area Description Complete Building or Area Category Function Area STATE OF CALIFORNIA Indoor Lighting NRCC-LTI-E CERTIFICATE OF COMPLIANCE Project Name: Pine Mountain Communications Pine Mountain Communications Project Name:</th> <th>(W/ft²) Area (ft²) (Watts) Area Category PAF CALIFORNIA ENERGY COMMISSION NRCC-LTI-F</th>	STATE OF CALIFORNIA Indoor Lighting NRCC-LTI-E CALIFORNIA ENERGY COMMISSION CERTIFICATE OF COMPLIANCE NRCC-LTI-E	Area Description Complete Building or Area Category Function Area STATE OF CALIFORNIA Indoor Lighting NRCC-LTI-E CERTIFICATE OF COMPLIANCE Project Name: Pine Mountain Communications Pine Mountain Communications Project Name:	(W/ft²) Area (ft²) (Watts) Area Category PAF CALIFORNIA ENERGY COMMISSION NRCC-LTI-F
Combined for compliance per S140.6(c)1 S140.6(c)2	STATE OF CALIFORNIA Indoor Lighting NRCC-LTI-E CALIFORNIA ENERGY COMMISSION CERTIFICATE OF COMPLIANCE Project Name: Project Name: Pine Mountain Communications Vault Project Address: Pine Mountain Road Date Prepared: 4/26/2024	STATE OF CALIFORNIA Indoor Lighting NRCC-LTI-E CERTIFICATE OF COMPLIANCE Project Name: Project Address: Complete Building or Area Category Foundation of Function Area Pine Mountain Communication Pine I	(W/ft²) Area (ft²) (Watts) Area Category PAF CALIFORNIA ENERGY COMMISSION NRCC-LTI-E
combined for compliance per \$140.6(b)1 Side Table I) (See Table II) (See Table II) (See Table III) (See Table IIII) (See Table IIIIIIIIIIIIIIIIIIIIIIIIIIIIIIIIIIII	STATE OF CALIFORNIA Indoor Lighting NRCC-LTI-E CALIFORNIA ENERGY COMMISSION CERTIFICATE OF COMPLIANCE Project Name: Pine Mountain Communications Vault Report Page: (Page 5 of 7)	Area Description Complete Building or Area Category Function Area STATE OF CALIFORNIA Indoor Lighting NRCC-LTI-E CERTIFICATE OF COMPLIANCE Project Name: Pine Mountain Communications Pine Mountain Communications Project Name:	CALIFORNIA ENERGY COMMISSION NRCC-LTI-E Runications Vault Report Page: (Page 7 of 7) Remountain Road Date Prepared: 4/26/2024
Combined for compliance per S140.6(c)1 S140.6(c)2	STATE OF CALIFORNIA Indoor Lighting NRCC-LTI-E PROJECT Name: Prine Mountain Communications Vault Report Page: Project Address: Pine Mountain Road Date Prepared: M. ADDITIONAL LIGHTING ALLOWANCE: TAILORED FLOOR AND TASK LIGHTING This section does not apply to this project.	STATE OF CALIFORNIA Indoor Lighting NRCC-LTI-E CERTIFICATE OF COMPLIANCE Project Name: Project Address: Pine Mountain Communication Project Address: DOCUMENTATION AUTHOR'S DECLARATION STATEMENT I certify that this Certificate of Compliance documentation is accurate Documentation Author Name	CALIFORNIA ENERGY COMMISSION NRCC-LTI-I Iunications Vault Report Page: (Page 7 of 7) Mountain Road Date Prepared: 4/26/2024
combined for compliance per \$140.6(c)1	STATE OF CALIFORNIA Indoor Lighting NRCC-LTI-E PROJECT Name: Prine Mountain Communications Vault Report Page: Project Address: Pine Mountain Road Date Prepared: M. ADDITIONAL LIGHTING ALLOWANCE: TAILORED FLOOR AND TASK LIGHTING This section does not apply to this project. N. ADDITIONAL LIGHTING ALLOWANCE: TAILORED ORNAMENTAL/SPECIAL EFFECTS	Area Description Complete Building or Area Category Function Area STATE OF CALIFORNIA Indoor Lighting NRCC-LTI-E CERTIFICATE OF COMPLIANCE Project Name: Project Address: Pine Mountain Community Project Address: Pine I DOCUMENTATION AUTHOR'S DECLARATION STATEMENT I certify that this Certificate of Compliance documentation is accurate Documentation Author Name Mike Johnston	(W/ft²) Area (ft²) (Watts) Area Category PAF CALIFORNIA ENERGY COMMISSION NRCC-LTI- nunications Vault Report Page: (Page 7 of 7) Mountain Road Date Prepared: 4/26/2024 e and complete. Documentation Author Signature: Wike Johnston
combined for compliance per \$140.6(b)1 S140.6(c)2 S1	STATE OF CALIFORNIA Indoor Lighting NRCC-LTI-E PROJECT Name: Prine Mountain Communications Vault Report Page: Project Address: Pine Mountain Road Date Prepared: M. ADDITIONAL LIGHTING ALLOWANCE: TAILORED FLOOR AND TASK LIGHTING This section does not apply to this project.	STATE OF CALIFORNIA Indoor Lighting NRCC-LTI-E CERTIFICATE OF COMPLIANCE Project Name: Project Address: Pine Mountain Communication Project Address: DOCUMENTATION AUTHOR'S DECLARATION STATEMENT I certify that this Certificate of Compliance documentation is accurate Documentation Author Name	CALIFORNIA ENERGY COMMISSION NRCC-LTI-F sunications Vault Report Page: (Page 7 of 7) Mountain Road Date Prepared: 4/26/2024 e and complete. Documentation Author Signature: Wiks Johnston Signature Date: 2024-04-26
combined for compliance per \$140.6(c)1	STATE OF CALIFORNIA Indoor Lighting NRCC-LTI-E PROJECT Name: Prine Mountain Communications Vault Report Page: Project Address: Pine Mountain Road Date Prepared: M. ADDITIONAL LIGHTING ALLOWANCE: TAILORED FLOOR AND TASK LIGHTING This section does not apply to this project. N. ADDITIONAL LIGHTING ALLOWANCE: TAILORED ORNAMENTAL/SPECIAL EFFECTS	Area Description Complete Building or Area Category Function Area STATE OF CALIFORNIA Indoor Lighting NRCC-LTI-E CERTIFICATE OF COMPLIANCE Project Name: Project Address: Pine Mountain Community Project Address: Pine I DOCUMENTATION AUTHOR'S DECLARATION STATEMENT I certify that this Certificate of Compliance documentation is accurate Documentation Author Name Mike Johnston Company:	(W/ft²) Area (ft²) (Watts) Area Category PAF CALIFORNIA ENERGY COMMISSION NRCC-LTI-F Funications Vault Report Page: (Page 7 of 7) Remountain Road Date Prepared: Area Category PAF CALIFORNIA ENERGY COMMISSION NRCC-LTI-F Unications Vault Report Page: (Page 7 of 7) Area Category NRCC-LTI-F Unications Vault Signature Date: Area Category PAF
Combined for compliance per \$140.6(c)	STATE OF CALIFORNIA Indoor Lighting NRCC-LITI-E CALIFORNIA ENERGY COMMISSION CERTIFICATE OF COMPLIANCE Project Name: Pine Mountain Communications Vault Report Page: (Page 5 of 7) Project Address: Pine Mountain Road Date Prepared: 4/26/2024 M. ADDITIONAL LIGHTING ALLOWANCE: TAILORED FLOOR AND TASK LIGHTING This section does not apply to this project. N. ADDITIONAL LIGHTING ALLOWANCE: TAILORED ORNAMENTAL/SPECIAL EFFECTS This section does not apply to this project.	STATE OF CALIFORNIA Indoor Lighting NRCC-LTI-E CERTIFICATE OF COMPLIANCE Project Name: Project Address: Pine Mountain Commu. Project Address: Pine I DOCUMENTATION AUTHOR'S DECLARATION STATEMENT I certify that this Certificate of Compliance documentation is accurate Documentation Author Name Mike Johnston Company: Engineering Enterprises Inc Address: 613 Fourth Street Suite 206B City/State/Zip:	CALIFORNIA ENERGY COMMISSION NRCC-LTI-E Tunications Vault Report Page: (Page 7 of 7) Mountain Road Date Prepared: 4/26/2024 Documentation Author Signature: Wike Johnston Signature Date: 2024-04-26 CEA/ HERS Certification Identification (if applicable): Phone:
Combined for compliance per \$140.6(c)1 \$140.6(c)2 \$140.	STATE OF CALIFORNIA Indoor Lighting NRCC-LTI-E PROJECT Name: Pine Mountain Communications Vault Report Page: Project Name: Pine Mountain Communications Vault Report Page: Project Address: Pine Mountain Road Date Prepared: 4/26/2024 M. ADDITIONAL LIGHTING ALLOWANCE: TAILORED FLOOR AND TASK LIGHTING This section does not apply to this project. N. ADDITIONAL LIGHTING ALLOWANCE: TAILORED ORNAMENTAL/SPECIAL EFFECTS This section does not apply to this project. O. ADDITIONAL LIGHTING ALLOWANCE: TAILORED VERY VALUABLE MERCHANDISE	STATE OF CALIFORNIA Indoor Lighting NRCC-LTI-E CERTIFICATE OF COMPLIANCE Project Name: Project Address: Pine Mountain Community Project Address: Pine I DOCUMENTATION AUTHOR'S DECLARATION STATEMENT I certify that this Certificate of Compliance documentation is accurate Documentation Author Name Mike Johnston Company: Engineering Enterprises Inc Address: 613 Fourth Street Suite 206B City/State/Zip: Santa Rosa CA 95404	CALIFORNIA ENERGY COMMISSION NRCC-LTI-F sunications Vault Report Page: (Page 7 of 7) Mountain Road Date Prepared: 4/26/2024 e and complete. Documentation Author Signature: Wiks Johnston Signature Date: 2024-04-26
combined for complience per \$140.6(c)1 \$140.6(c)2 \$140	STATE OF CALIFORNIA Indoor Lighting NRCCUTIE CERTIFICATE OF COMPLIANCE Project Name: Pine Mountain Communications Vault Report Page: Project Address: Pine Mountain Road Date Prepared: M. ADDITIONAL LIGHTING ALLOWANCE: TAILORED FLOOR AND TASK LIGHTING This section does not apply to this project. M. ADDITIONAL LIGHTING ALLOWANCE: TAILORED ORNAMENTAL/SPECIAL EFFECTS This section does not apply to this project. O. ADDITIONAL LIGHTING ALLOWANCE: TAILORED VERY VALUABLE MERCHANDISE This section does not apply to this project.	STATE OF CALIFORNIA Indoor Lighting NRCC-LTI-E CERTIFICATE OF COMPLIANCE Project Name: Project Address: Pine Mountain Commu Project Address: Pine I DOCUMENTATION AUTHOR'S DECLARATION STATEMENT I certify that this Certificate of Compliance documentation is accurate Documentation Author Name Mike Johnston Company: Engineering Enterprises Inc Address: 613 Fourth Street Suite 206B City/State/Zip: Santa Rosa CA 95404 RESPONSIBLE PERSON'S DECLARATION STATEMENT I certify the following under penalty of perjury, under the laws of the State of California:	CALIFORNIA ENERGY COMMISSION NRCC-LTI-E Tunications Vault Report Page: (Page 7 of 7) Mountain Road Date Prepared: 4/26/2024 Documentation Author Signature: Wike Johnston Signature Date: 2024-04-26 CEA/ HERS Certification Identification (if applicable): Phone:
combined for compliance ps st40.6(c)1	STATE OF CALIFORNIA Indoor Lighting NECCLITE CERTIFICATE CALIFORNIA ENERGY COMMISSION CERTIFICATE OF COMPLIANCE Project Name: Pine Mountain Communications Vault Report Page: (Page 5 of 7) Project Address: Pine Mountain Road Date Prepared: 4/26/2024 M. ADDITIONAL LIGHTING ALLOWANCE: TAILORED FLOOR AND TASK LIGHTING This section does not apply to this project. N. ADDITIONAL LIGHTING ALLOWANCE: TAILORED ORNAMENTAL/SPECIAL EFFECTS This section does not apply to this project. O. ADDITIONAL LIGHTING ALLOWANCE: TAILORED VERY VALUABLE MERCHANDISE This section does not apply to this project. P. POWER ADJUSTMENT: LIGHTING CONTROL CREDIT (POWER ADJUSTMENT FACTOR (PAF)) This section does not apply to this project.	Area Description Complete Building or Area Category Function Area STATE OF CALIFORNIA Indoor Lighting NRCC-LTI-E CERTIFICATE OF COMPLIANCE Project Name: Project Address: Pine Mountain Commu. Project Address: Pine I DOCUMENTATION AUTHOR'S DECLARATION STATEMENT I certify that this Certificate of Compliance documentation is accurate Documentation Author Name Mike Johnston Company: Engineering Enterprises Inc Address: 613 Fourth Street Suite 206B City/State/Zip: Santa Rosa CA 95404 RESPONSIBLE PERSON'S DECLARATION STATEMENT I certify the following under penalty of perjury, under the laws of the State of California: 1. The information provided on this Certificate of Compliance is true and correct. 2. I am eligible under Division 3 of the Business and Professions Code to accept responsi	CALIFORNIA ENERGY COMMISSION NRCC-LTI-I Funications Vault Report Page: Mountain Road Date Prepared: Page 7 of 7 Area (ft²) (Watts) NRCC-LTI-I Page 7 of 7 Page 8 of 7 Page 7 of 7 Page 8 of 7 Page 7 of 7 Page 8 of 7 Page 8 of 7 Page 7 of 7 Page 8 of
combined for compliance per \$\frac{140.6(b)1}{340.6(c)2}\$ \$\frac{140.6(c)2}{540.6(c)2}\$ \$	STATE OF CALIFORNIA Indoor Lighting NECCLTI-E PROBECT NAME: Propert Name: Pine Mountain Communications Vault Report Page: Propert Address: Pine Mountain Road Date Prepared: M. ADDITIONAL LIGHTING ALLOWANCE: TAILORED FLOOR AND TASK LIGHTING This section does not apply to this project. M. ADDITIONAL LIGHTING ALLOWANCE: TAILORED ORNAMENTAL/SPECIAL EFFECTS This section does not apply to this project. O. ADDITIONAL LIGHTING ALLOWANCE: TAILORED VERY VALUABLE MERCHANDISE This section does not apply to this project. R. POWER ADJUSTMENT: LIGHTING CONTROL CREDIT (POWER ADJUSTMENT FACTOR (PAF)) This section does not apply to this project. O. RATED POWER REDUCTION COMPLIANCE FOR ALTERATIONS	Area Description Complete Building or Area Category Function Area STATE OF CALIFORNIA Indoor Lighting NRCC-LTI-E CERTIFICATE OF COMPLIANCE Project Name: Project Address: Pine Mountain Commu. Project Address: Pine I DOCUMENTATION AUTHOR'S DECLARATION STATEMENT I certify that this Certificate of Compliance documentation is accurate Documentation Author Name Mike Johnston Company: Engineering Enterprises Inc Address: 613 Fourth Street Suite 206B City/State/Zip: Santa Rosa CA 95404 RESPONSIBLE PERSON'S DECLARATION STATEMENT I certify the following under penalty of perjury, under the laws of the State of California: 1. The information provided on this Certificate of Compliance is true and correct. 2. I am eligible under Division 3 of the Business and Professions Code to accept responsi	CALIFORNIA ENERGY COMMISSION RRCC-LTI-F Tunications Vault Report Page: Mountain Road Date Prepared: Documentation Author Signature: Documentation Author Signature: Wike Johnston Signature Date: 2024-04-26 CEA/ HERS Certification Identification (if applicable): Phone: 707.544-7775
Combined for compliance per Sild Gig	STATE OF CALIFORNIA Indoor Lighting NECCLITE CERTIFICATE CALIFORNIA ENERGY COMMISSION CERTIFICATE OF COMPLIANCE Project Name: Pine Mountain Communications Vault Report Page: (Page 5 of 7) Project Address: Pine Mountain Road Date Prepared: 4/26/2024 M. ADDITIONAL LIGHTING ALLOWANCE: TAILORED FLOOR AND TASK LIGHTING This section does not apply to this project. N. ADDITIONAL LIGHTING ALLOWANCE: TAILORED ORNAMENTAL/SPECIAL EFFECTS This section does not apply to this project. O. ADDITIONAL LIGHTING ALLOWANCE: TAILORED VERY VALUABLE MERCHANDISE This section does not apply to this project. P. POWER ADJUSTMENT: LIGHTING CONTROL CREDIT (POWER ADJUSTMENT FACTOR (PAF)) This section does not apply to this project.	Area Description Complete Building or Area Category Function Area STATE OF CALIFORNIA Indoor Lighting NRCC-LTI-E CERTIFICATE OF COMPLIANCE Project Name: Project Address: Pine Mountain Commu. Project Address: Pine I DOCUMENTATION AUTHOR'S DECLARATION STATEMENT I certify that this Certificate of Compliance documentation is accurate Documentation Author Name Mike Johnston Company: Engineering Enterprises Inc Address: 613 Fourth Street Suite 206B City/State/Zip: Santa Rosa CA 95404 RESPONSIBLE PERSON'S DECLARATION STATEMENT I certify the following under penalty of perjury, under the laws of the State of California: 1. The information provided on this Certificate of Compliance is true and correct. 2. I am eligible under Division 3 of the Business and Professions Code to accept responsi 3. The energy features and performance specifications, materials, components, and mar of Title 24, Part 1 and Part 6 of the California Code of Regulations. 4. The building design features or system design features identified on this Certificate of	CALIFORNIA ENERGY COMMISSION NRCC-LTI-I unications Vault Nountain Road Date Prepared: Documentation Author Signature: Signature Date: 2024-04-26 CEA/ HERS Certification Identification (if applicable): Phone: 707.544-7775 Sibility for the building design or system design identified on this Certificate of Compliance (responsible designer) anufactured devices for the building design or system design identified on this Certificate of Compliance conform to the requirements of Compliance are consistent with the information provided on other applicable compliance documents, worksheets, calculations,
Combined for compliance Sal 0.6(c) Sa	STATE OF CALIFORNIA Indoor Lighting NECCLTI-E PROBECT NAME: Propert Name: Pine Mountain Communications Vault Report Page: Propert Address: Pine Mountain Road Date Prepared: M. ADDITIONAL LIGHTING ALLOWANCE: TAILORED FLOOR AND TASK LIGHTING This section does not apply to this project. M. ADDITIONAL LIGHTING ALLOWANCE: TAILORED ORNAMENTAL/SPECIAL EFFECTS This section does not apply to this project. O. ADDITIONAL LIGHTING ALLOWANCE: TAILORED VERY VALUABLE MERCHANDISE This section does not apply to this project. R. POWER ADJUSTMENT: LIGHTING CONTROL CREDIT (POWER ADJUSTMENT FACTOR (PAF)) This section does not apply to this project. O. RATED POWER REDUCTION COMPLIANCE FOR ALTERATIONS	Area Description Complete Building or Area Category Function Area STATE OF CALIFORNIA Indoor Lighting NRCC-LTI-E CERTIFICATE OF COMPLIANCE Project Name: Project Address: Pine Mountain Community Project Address: Pine I DOCUMENTATION AUTHOR'S DECLARATION STATEMENT I certify that this Certificate of Compliance documentation is accurate Documentation Author Name Mike Johnston Company: Engineering Enterprises Inc Address: 613 Fourth Street Suite 206B City/State/Zip: Santa Rosa CA 95404 RESPONSIBLE PERSON'S DECLARATION STATEMENT I certify the following under penalty of perjury, under the laws of the State of California: 1. The information provided on this Certificate of Compliance is true and correct. 2. I am eligible under Division 3 of the Business and Professions Code to accept responsis 3. The energy features and performance specifications, materials, components, and man of Title 24, Part 1 and Part 6 of the California Code of Regulations. 4. The building design features or system design features identified on this Certificate of plans and specifications submitted to the enforcement agency for approval with this besigned to possible plans and specifications submitted to the enforcement agency for approval with this besigned copy of this Certificate of Compliance shall be means and professions contents agency for approval with this besigned copy of this Certificate of Compliance shall be means and professions.	CALIFORNIA ENERGY COMMISSION NRCC-LTI- Junications Vault Report Page: (Page 7 of 7; Mountain Road Date Prepared: 4/26/2024 E and complete. Documentation Author Signature: Wike Johnston Signature Date: 2024-04-26 CEA/ HERS Certification Identification (if applicable): Phone: 707.544-7775 Sibility for the building design or system design identified on this Certificate of Compliance (responsible designer) and active devices for the building design or system design identified on on the rapplicable compliance conform to the requirements of Compliance are consistent with the information provided on other applicable compliance documents, worksheets, calculations, building permit application. Marca Category PAF CALIFORNIA ENERGY COMMISSION NRCC-LTI- (Page 7 of 7; 4/26/2024
Combined for compliance Sit S	STATE OF CALIFORNIA Indoor Lighting NICCLITIE INCCLITIE Project Name: Pine Mountain Communications Vault Report Page: Project Address: Pine Mountain Road Date Prepared: M. ADDITIONAL LIGHTING ALLOWANCE: TAILORED FLOOR AND TASK LIGHTING This section does not apply to this project. M. ADDITIONAL LIGHTING ALLOWANCE: TAILORED FLOOR AND TASK LIGHTING This section does not apply to this project. O. ADDITIONAL LIGHTING ALLOWANCE: TAILORED VERY VALUABLE MERCHANDISE This section does not apply to this project. P. POWER ADJUSTMENT: LIGHTING CONTROL CREDIT (POWER ADJUSTMENT FACTOR (PAF)) This section does not apply to this project. O. RATED POWER REDUCTION COMPLIANCE FOR ALTERATIONS This section does not apply to this project.	STATE OF CALIFORNIA Indoor Lighting NRCC-LTI-E CERTIFICATE OF COMPLIANCE Project Name: Project Address: Pine Mountain Commu Project Address: Pine I DOCUMENTATION AUTHOR'S DECLARATION STATEMENT I certify that this Certificate of Compliance documentation is accurate Documentation Author Name Mike Johnston Company: Engineering Enterprises Inc Address: 613 Fourth Street Suite 206B City/State/Zip: Santa Rosa CA 95404 RESPONSIBLE PERSON'S DECLARATION STATEMENT I certify the following under penalty of perjury, under the laws of the State of California: 1. The information provided on this Certificate of Compliance is true and correct. 2. I am eligible under Division's of the Business and Professions Code to accept responsi 3. The energy features and performance specifications, materials, components, and mar of Title 24, Part 1 and Part 6 of the California Code of Regulations. 4. The building design features or system design features identified on this Certificate of plans and specifications submitted to the enforcement agency for approval with this b 5. I will ensure that a completed signed copy of this Certificate of Compliance shall be m inspections. I understand that a completed signed copy of this Certificate of Compliance Responsible Designer Name:	CALIFORNIA ENERGY COMMISSION CALIFORNIA ENERGY COMMISSION NRCC-LTH- Bunications Vault Report Page: (Page 7 of 7) Mountain Road Date Prepared: 4/26/2024 Date Prepared: 4/26/2024 Documentation Author Signature: Wikks Johnston Signature Date: 2024-04-26 CEA/ HERS Certification Identification (if applicable): Phone: 707.544-7775 sibility for the building design or system design identified on this Certificate of Compliance (responsible designer) insufactured devices for the building design or system design identified on this Certificate of Compliance conform to the requirements of Compliance are consistent with the information provided on other applicable compliance documents, worksheets, calculations, building permit application. made available with the building permit(s) issued for the building, and made available to the enforcement agency for all applicable neces is required to be included with the documentation the building provides to the building owner at occupancy.
Sulforming Su	STATE OF CALIFORNIA Indoor Lighting InccCaTTE CERTIFICATE OF COMPLIANCE Project Mame Pine Mountain Communications Vault Report Page: NRCC4TTE Project Address: Pine Mountain Rose Date Prepared: 4/26/2024 M. ADDITIONAL LIGHTING ALLOWANCE: TAILORED FLOOR AND TASK LIGHTING This section does not apply to this project. N. ADDITIONAL LIGHTING ALLOWANCE: TAILORED ORNAMENTAL/SPECIAL EFFECTS This section does not apply to this project. D. ADDITIONAL LIGHTING ALLOWANCE: TAILORED VERY VALUABLE MERCHANDISE This section does not apply to this project. P. POWER ADJUSTMENT: LIGHTING CONTROL CREDIT (POWER ADJUSTMENT FACTOR (PAF)) This section does not apply to this project. C. RATED POWER REDUCTION COMPLIANCE FOR ALTERATIONS This section does not apply to this project. R. 80% LIGHTING POWER FOR ALL ALTERATIONS - CONTROLS EXCEPTIONS This section does not apply to this project.	Area Description Complete Building or Area Category Function Area STATE OF CALIFORNIA Indoor Lighting NRCC-LTI-E CERTIFICATE OF COMPLIANCE Project Name: Project Address: Pine Mountain Community Project Address: Pine I DOCUMENTATION AUTHOR'S DECLARATION STATEMENT I certify that this Certificate of Compliance documentation is accurate Documentation Author Name Mike Johnston Company: Engineering Enterprises Inc Address: 613 Fourth Street Suite 206B City/State/Zip: Santa Rosa CA 95404 RESPONSIBLE PERSON'S DECLARATION STATEMENT I certify the following under penalty of perjury, under the laws of the State of California: 1. The information provided on this Certificate of Compliance is true and correct. 2. I am eligible under Division 3 of the Business and Professions Code to accept responsis 3. The energy features and performance specifications, materials, components, and mar of Title 24, Part 1 and Part 6 of the California Code of Regulations. 4. The building design features or system design features identified on this Certificate of plans and specifications submitted to the enforcement agency for approval with this b 5. I will ensure that a completed signed copy of this Certificate of Compliance shall be m inspections. I understand that a completed signed copy of this Certificate of Complian Responsible Designer Name: Mike Johnston	CALIFORNIA ENERGY COMMISSION NRCC-LTI-I Funications Vault Report Page: (Page 7 of 7 Mountain Road Date Prepared: 4/26/2024 Documentation Author Signature: Wike Johnston Signature Date: 2024-04-26 CEA/ HERS Certification Identification (if applicable): Phone: 707.544-7775 Sibility for the building design or system design identified on this Certificate of Compliance (responsible designer) murfactured devices for the building design or system design identified on this Certificate of Compliance conform to the requirements of Compliance are consistent with the information provided on other applicable compliance documents, worksheets, calculations, building permit application. The Agree of Compliance are consistent with the information provided on other applicable compliance documents, worksheets, calculations, building permit application: made available with the building permit(s) issued for the building, and made available to the enforcement agency for all applicable more is required to be included with the documentation the building powner at occupancy. Responsible Designer Signature: Wike Johnston
Extra conditioned Sado, Sicil Sado, Sici	STATE OF CALEFORNIA Indoor Lighting Inccurre Incorre Inccurre Inccurre Incorre	STATE OF CALIFORNIA Indoor Lighting NRCC-LTI-E CERTIFICATE OF COMPLIANCE Project Name: Project Address: Pine Mountain Commu Project Address: Pine I DOCUMENTATION AUTHOR'S DECLARATION STATEMENT I certify that this Certificate of Compliance documentation is accurate Documentation Author Name Mike Johnston Company: Engineering Enterprises Inc Address: 613 Fourth Street Suite 206B City/State/Zip: Santa Rosa CA 95404 RESPONSIBLE PERSON'S DECLARATION STATEMENT I certify the following under penalty of perjury, under the laws of the State of California: 1. The information provided on this Certificate of Compliance is true and correct. 2. I am eligible under Division's of the Business and Professions Code to accept responsi 3. The energy features and performance specifications, materials, components, and mar of Title 24, Part 1 and Part 6 of the California Code of Regulations. 4. The building design features or system design features identified on this Certificate of plans and specifications submitted to the enforcement agency for approval with this b 5. I will ensure that a completed signed copy of this Certificate of Compliance shall be m inspections. I understand that a completed signed copy of this Certificate of Compliance Responsible Designer Name:	CALIFORNIA ENERGY COMMISSION CALIFORNIA ENERGY COMMISSION NRCC-LTH- Bunications Vault Report Page: (Page 7 of 7) Mountain Road Date Prepared: 4/26/2024 Date Prepared: 4/26/2024 Documentation Author Signature: Wikks Johnston Signature Date: 2024-04-26 CEA/ HERS Certification Identification (if applicable): Phone: 707.544-7775 sibility for the building design or system design identified on this Certificate of Compliance (responsible designer) insufactured devices for the building design or system design identified on this Certificate of Compliance conform to the requirements of Compliance are consistent with the information provided on other applicable compliance documents, worksheets, calculations, building permit application. made available with the building permit(s) issued for the building, and made available to the enforcement agency for all applicable neces is required to be included with the documentation the building provides to the building owner at occupancy.
Designed Control Credits Subject Control Credits Subject	SANTE OF CAUFORNIA Indoor Lighting NECCLITE CERTIFICATE OF COMPUIANCE Project Name: Price Mountain Communications Vauh Report Page: Project Address: Price Mountain Road Date Prepared: A728/2028 M. ADDITIONAL LIGHTING ALLOWANCE: TAILORED FLOOR AND TASK LIGHTING This section does not apply to this project. N. ADDITIONAL EIGHTING ALLOWANCE: TAILORED ORNAMENTAL/SPECIAL EFFECTS This section does not apply to this project. O. ADDITIONAL LIGHTING ALLOWANCE: TAILORED ORNAMENTAL/SPECIAL EFFECTS This section does not apply to this project. R. POWER ADJUSTMENT: LIGHTING CONTROL CREDIT (POWER ADJUSTMENT FACTOR (PAF)) This section does not apply to this project. Q. RATED POWER REDUCTION COMPILIANCE FOR ALTERATIONS This section does not apply to this project. R. 80% LIGHTING POWER ROA ALL ALTERATIONS - CONTROLS EXCEPTIONS This section does not apply to this project. S. DAYLIGHT DESIGN POWER ADJUSTMENT FACTOR (PAF) This section does not apply to this project.	Area Description Complete Building or Area Category F Function Area Indoor Lighting NRCC-UTI-E CERTIFICATE OF COMPLIANCE Project Name: Project Address: Pine Mountain Commu Project Address: Pine I DOCUMENTATION AUTHOR'S DECLARATION STATEMENT I certify that this Certificate of Compliance documentation is accurate Documentation Author Name Mike Johnston Company: Engineering Enterprises Inc Address: 613 Fourth Street Suite 206B City/State/Zip: Santa Rosa CA 95404 RESPONSIBLE PERSON'S DECLARATION STATEMENT I certify the following under penalty of perjury, under the laws of the State of California: 1. The information provided on this Certificate of Compliance is true and correct. 2. I am eligible under Division 3 of the Business and Professions Code to accept responsi 3. The energy features and performance specifications, materials, components, and mar of Title 24, Part 1 and Part 6 of the California Code of Regulations. 4. The building design features or system design features identified on this Certificate of plans and specifications submitted to the enforcement agency for approval with this to plans and specifications submitted to the enforcement agency for approval with this 1. 5. I will ensure that a completed signed copy of this Certificate of Complian Responsible Designer Name: Mike Johnston Company: Engineering Enterprises Inc. Address:	CALIFORNIA ENERGY COMMISSION NRCC-ITI-I nunications Vault Report Page: (Page 7 of 7, 12 Mountain Road Date Prepared: 4/26/2024 Mountain Road Date Prepared: 4/26/2024 Documentation Author Signature: Wike Johnston Signature Date: 2024-04-26 CER/ HERS Certification Identification (if applicable): Phone: 707.544-7775 Sibility for the building design or system design identified on this Certificate of Compliance (responsible designer) Intrifactured devices for the building design or system design identified on this Certificate of Compliance conform to the requirements of Compliance are consistent with the information provided on other applicable compliance documents, worksheets, calculations, building permit application. made available with the building permit(s) issued for the building, and made available to the enforcement agency for all applicable note is required to be included with the documentation the builder provides to the building owner at occupancy. Responsible Designer Signature: Wike Johnston Date Signed: 2024-04-26
Substitute Sub	STATE OF CALIFORNIA Indoor Lighting NECCLTE PROJECT NAME NAME PROJECT NAME NAME PROJECT NAME NAME NAME NAME NAME NAME NAME NAME	Area Description Complete Building or Area Category Function Area Indoor Lighting NRCC-LTI-E CERTIFICATE OF COMPLIANCE Project Name: Project Address: Pine Mountain Comme Project Address: Pine I DOCUMENTATION AUTHOR'S DECLARATION STATEMENT I certify that this Certificate of Compliance documentation is accurate Documentation Author Name Mike Johnston Company: Engineering Enterprises Inc Address: 613 Fourth Street Suite 206B City/State/Zip: Santa Rosa CA 95404 RESPONSIBLE PERSON'S DECLARATION STATEMENT I certify the following under penalty of perjury, under the laws of the State of California: 1. The information provided on this Certificate of Compliance is true and correct. 2. I am eligible under Division 3 of the Business and Professions Code to accept responsi 3. The energy features and performance specifications, materials, components, and mar of Title 24, Part 1 and Part 6 of the California Code of Regulations. 4. The building design features or system design features identified on this Certificate of plans and specifications submitted to the enforcement agency for approval with this to plan and specifications submitted to the enforcement agency for approval with this to plan and specifications submitted to the enforcement agency for approval with this to plan and specifications submitted to the enforcement agency for approval with this to plan and specifications submitted to the enforcement agency for approval with this to plan and specifications submitted to the enforcement agency for approval with this to plan and specifications submitted to the enforcement agency for approval with this to plan and specifications submitted to the enforcement agency for approval with this to plan and specifications submitted to the enforcement agency for approval with this to plan and specifications submitted to the enforcement agency for approval with this to plan and specifications submitted to the enforcement agency for approval with this to plan and specifications submitted to the enforcement agency for approval wi	CALIFORNIA ENERGY COMMISSION CALIFORNIA ENERGY COMMISSION NRCC-LTH- nunications Wault Report Page: (Page 7 of 7/ Mountain Road Date Prepared: 4/26/2024 Mountain Road Date Prepared: 4/26/2024 Documentation Author Signature: Wike Johnston Signature Date: 2024-04-26 CEX/ HERS Certification Identification (if applicable): Phone: 707.544-7775 sibility for the building design or system design identified on this Certificate of Compliance (responsible designer) simufactured devices for the building design or system design identified on this Certificate of Compliance conform to the requirements of Compliance are consistent with the information provided on other applicable compliance documents, worksheets, calculations, building permit application. made available with the building permit(s) issued for the building, and made available to the enforcement agency for all applicable note is required to be included with the documentation the builder provides to the building owner at occupancy. Responsible Designet: 2024-04-26 License: E 15586 Phone:
Substitution Subs	SIGNE OF CALIFORNIA Indoor Lighting Indoor In	STATE OF CALIFORNIA Indoor Lighting NRCC-LTI-E CERTIFICATE OF COMPLIANCE Project Name: Project Address: Pine Mountain Commu Project Address: Pine I DOCUMENTATION AUTHOR'S DECLARATION STATEMENT I certify that this Certificate of Compliance documentation is accurate Documentation Author Name Mike Johnston Company: Engineering Enterprises Inc: Address: 613 Fourth Street Suite 206B City/State/Zip: Santa Rosa CA 95404 RESPONSIBLE PERSON'S DECLARATION STATEMENT I certify the following under penalty of perjury, under the laws of the State of California: 1. The information provided on this Certificate of Compliance is true and correct. 2. I am eligible under Division 3 of the Business and Professions Code to accept responsi 3. The energy features and performance specifications, materials, components, and mar of Title 24, Part 1 and Part 6 of the California Code of Regulations. 4. The building design features or system design features identified on this Certificate of plans and specifications submitted to the enforcement agency for approval with this to specifications submitted to the enforcement agency for approval with this to specifications in specifications. I understand that a completed signed copy of this Certificate of Compliance shall be main spections. I understand that a completed signed copy of this Certificate of Compliance Responsible Designer Name: Mike Johnston Company: Engineering Enterprises Inc. Address: 613 Fourth Street, Suite 206B	CALIFORNIA ENERGY COMMISSION NRCCLIFI Intuications Vault Report Page: (Page 7 of 7 Mountain Road Date Prepared: 4/26/2024 Mountain Road Date Prepared: 4/26/2024 Bocumentation Author Signature: Muke Johnston Signature Date: 2024-04-26 CEA/ HERS Certification Identification (if applicable): Phone: 707.544-7775 Sibility for the building design or system design identified on this Certificate of Compliance (responsible designer) Ininfactured devices for the building design or system design identified on this Certificate of Compliance conform to the requirements of Compliance are consistent with the information provided on other applicable compliance documents, worksheets, calculations, building permit application. Made available with the building permit(s) issued for the building, and made available to the enforcement agency for all applicable noe is required to be included with the documentation the builder provides to the building owner at occupancy. Responsible Designed: 2024-04-26 License: E 15586
Communications Vault Electrical Mechanical Telephone Rock Communications Vault Electrical Mechanical Telephone Rock Communications Vault Electrical Mechanical Telephone Rock Conditioned Communications Vault Electrical Mechanical Telephone Rock Communications Vault Electrical Mechanical T	STATE OF CALIFORNIA. Indoor Lighting MICCLITE INCLUSE INCLUSE INCLUSIVE INC	Area Description Complete Building or Area Category Function Area Indoor Lighting NRCC-LTI-E CERTIFICATE OF COMPLIANCE Project Name: Project Address: Pine Mountain Comme Project Address: Pine I DOCUMENTATION AUTHOR'S DECLARATION STATEMENT I certify that this Certificate of Compliance documentation is accurate Documentation Author Name Mike Johnston Company: Engineering Enterprises Inc Address: 613 Fourth Street Suite 206B City/State/Zip: Santa Rosa CA 95404 RESPONSIBLE PERSON'S DECLARATION STATEMENT I certify the following under penalty of perjury, under the laws of the State of California: 1. The information provided on this Certificate of Compliance is true and correct. 2. I am eligible under Division 3 of the Business and Professions Code to accept responsi 3. The energy features and performance specifications, materials, components, and mar of Title 24, Part 1 and Part 6 of the California Code of Regulations. 4. The building design features or system design features identified on this Certificate of plans and specifications submitted to the enforcement agency for approval with this to plan and specifications submitted to the enforcement agency for approval with this to plan and specifications submitted to the enforcement agency for approval with this to plan and specifications submitted to the enforcement agency for approval with this to plan and specifications submitted to the enforcement agency for approval with this to plan and specifications submitted to the enforcement agency for approval with this to plan and specifications submitted to the enforcement agency for approval with this to plan and specifications submitted to the enforcement agency for approval with this to plan and specifications submitted to the enforcement agency for approval with this to plan and specifications submitted to the enforcement agency for approval with this to plan and specifications submitted to the enforcement agency for approval with this to plan and specifications submitted to the enforcement agency for approval wi	CALIFORNIA ENERGY COMMISSION CALIFORNIA ENERGY COMMISSION NRCC-LTH- nunications Wault Report Page: (Page 7 of 7/ Mountain Road Date Prepared: 4/26/2024 Mountain Road Date Prepared: 4/26/2024 Documentation Author Signature: Wike Johnston Signature Date: 2024-04-26 CEX/ HERS Certification Identification (if applicable): Phone: 707.544-7775 sibility for the building design or system design identified on this Certificate of Compliance (responsible designer) simufactured devices for the building design or system design identified on this Certificate of Compliance conform to the requirements of Compliance are consistent with the information provided on other applicable compliance documents, worksheets, calculations, building permit application. made available with the building permit(s) issued for the building, and made available to the enforcement agency for all applicable note is required to be included with the documentation the builder provides to the building owner at occupancy. Responsible Designet: 2024-04-26 License: E 15586 Phone:
Communications Value	SIZERS DP CAUPONNA Indoor Lighting MICCUTE CERTIFICATE OF COMPLIANCE Project Name Price Mountain Communications Value Report Page: Project Name Price Mountain Communications Value Report Page: Project Name Price Mountain Road Date Prepared: A728/2021 M. ADDITIONAL LIGHTING ALLOWANCE: TAILORED FLOOR AND TASK LIGHTING This section does not apply to this project. N. ADDITIONAL LIGHTING ALLOWANCE: TAILORED ORNAMENTAL/SPECIAL EFFECTS This section does not opply to this project. O. ADDITIONAL LIGHTING ALLOWANCE: TAILORED VERY VALUABLE MERCHANDISE This section does not apply to this project. O. ADDITIONAL LIGHTING ALLOWANCE: TAILORED VERY VALUABLE MERCHANDISE This section does not apply to this project. O. RATED POWER ADJUSTMENT: LIGHTING CONTROL CREDIT (POWER ADJUSTMENT FACTOR (PAF)) This section does not apply to this project. O. RATED POWER REDUCTION COMPLIANCE FOR ALTERATIONS This section does not apply to this project. R. 800% LIGHTING POWER FOR ALL ALTERATIONS - CONTROLS EXCEPTIONS This section does not apply to this project. T. DECLARATION OF REQUIRED CERTIFICATES OF INSTALLATION Selections have been made based on information provided in his document; If any selection have been changed by permit applicant, on explanation should be Included in Table E. Adolthout Remarks. Tailes documents must be provided to the building fragector during construction and can be pound colline at Laters Additional Remarks. These documents must be provided to the building fragector during construction and can be pound colline at Laters Additional Remarks. These documents must be provided to the building fragector during construction and can be pound colline at Laters Additional Remarks. Field inspector	Area Description Complete Building or Area Category Function Area Indoor Lighting NRCC-LTI-E CERTIFICATE OF COMPLIANCE Project Name: Project Address: Pine Mountain Comme Project Address: Pine I DOCUMENTATION AUTHOR'S DECLARATION STATEMENT I certify that this Certificate of Compliance documentation is accurate Documentation Author Name Mike Johnston Company: Engineering Enterprises Inc Address: 613 Fourth Street Suite 206B City/State/Zip: Santa Rosa CA 95404 RESPONSIBLE PERSON'S DECLARATION STATEMENT I certify the following under penalty of perjury, under the laws of the State of California: 1. The information provided on this Certificate of Compliance is true and correct. 2. I am eligible under Division 3 of the Business and Professions Code to accept responsi 3. The energy features and performance specifications, materials, components, and mar of Title 24, Part 1 and Part 6 of the California Code of Regulations. 4. The building design features or system design features identified on this Certificate of plans and specifications submitted to the enforcement agency for approval with this to plan and specifications submitted to the enforcement agency for approval with this to plan and specifications submitted to the enforcement agency for approval with this to plan and specifications submitted to the enforcement agency for approval with this to plan and specifications submitted to the enforcement agency for approval with this to plan and specifications submitted to the enforcement agency for approval with this to plan and specifications submitted to the enforcement agency for approval with this to plan and specifications submitted to the enforcement agency for approval with this to plan and specifications submitted to the enforcement agency for approval with this to plan and specifications submitted to the enforcement agency for approval with this to plan and specifications submitted to the enforcement agency for approval with this to plan and specifications submitted to the enforcement agency for approval wi	CALIFORNIA ENERGY COMMISSION CALIFORNIA ENERGY COMMISSION NRCC-LTH- nunications Wault Report Page: (Page 7 of 7/ Mountain Road Date Prepared: 4/26/2024 Mountain Road Date Prepared: 4/26/2024 Documentation Author Signature: Wike Johnston Signature Date: 2024-04-26 CEX/ HERS Certification Identification (if applicable): Phone: 707.544-7775 sibility for the building design or system design identified on this Certificate of Compliance (responsible designer) simufactured devices for the building design or system design identified on this Certificate of Compliance conform to the requirements of Compliance are consistent with the information provided on other applicable compliance documents, worksheets, calculations, building permit application. made available with the building permit(s) issued for the building, and made available to the enforcement agency for all applicable note is required to be included with the documentation the builder provides to the building owner at occupancy. Responsible Designet: 2024-04-26 License: E 15586 Phone:
Communications VauIt	STATE OF CAMPORNIA Indoor Lighting MICCUTIE INCOCATIE Project Name: Pine Mountain Communications Vauli Report Page: Pine Mountain Communications Vauli Report Page: Pine Mountain Road Prof. Project Address: Pine Mountain Road Prof. Prof. Project Address: Pine Mountain Road Prof. Prof. Project Address: N. ADDITIONAL LIGHTING ALLOWANCE: TAILORED FLOOR AND TASK LIGHTING This section does not apply to this project. O. ADDITIONAL LIGHTING ALLOWANCE: TAILORED VERY VALUABLE MERCHANDISE This section does not apply to this project. P. POWER ADJUSTMENT: LIGHTING CONTROL CREDIT (POWER ADJUSTMENT FACTOR (PAF)) This section does not apply to this project. O. RAIED POWER REDUCTION COMPLIANCE FOR ALTERATIONS This section does not apply to this project. R. 80% LIGHTING POWER FOR ALL ALTERATIONS - CONTROLS EXCEPTIONS This section does not apply to this project. S. DAYLIGHT DESIGN POWER ADJUSTMENT FACTOR (PAF) This section does not apply to this project. S. DAYLIGHT DESIGN POWER FOR ALL ALTERATIONS - CONTROLS EXCEPTIONS This section does not apply to this project. T. DECLARATION OF ROUISED CERTIFICATES OF INSTALLATION Selections have been node based on information provided in this document, if any selection have been changed by permit applicant, on explanation should be included in Table E. Additional Bear and S. These documents must be provided to the budding respected values construction and can be found annihe or a hipps://www.energy.co.gov/tibs24/2019standards/2019_congaliance_documents/Nonresidential_Documents/Nonresidential_Documents/Nonresidential_Documents/Nonresidential_Documents/Nonresidential_Documents/Nonresidential_Documents/Nonresidential_Documents/Nonresidential_Documents/Nonresidential_Documents/Nonresidential_Documents/Nonresidential_Documents/Nonresidential_Documents/Nonresidential_Documents/Nonresidential_Docume	Area Description Complete Building or Area Category Function Area Indoor Lighting NRCC-LTI-E CERTIFICATE OF COMPLIANCE Project Name: Project Address: Pine Mountain Comme Project Address: Pine I DOCUMENTATION AUTHOR'S DECLARATION STATEMENT I certify that this Certificate of Compliance documentation is accurate Documentation Author Name Mike Johnston Company: Engineering Enterprises Inc Address: 613 Fourth Street Suite 206B City/State/Zip: Santa Rosa CA 95404 RESPONSIBLE PERSON'S DECLARATION STATEMENT I certify the following under penalty of perjury, under the laws of the State of California: 1. The information provided on this Certificate of Compliance is true and correct. 2. I am eligible under Division 3 of the Business and Professions Code to accept responsi 3. The energy features and performance specifications, materials, components, and mar of Title 24, Part 1 and Part 6 of the California Code of Regulations. 4. The building design features or system design features identified on this Certificate of plans and specifications submitted to the enforcement agency for approval with this to plan and specifications submitted to the enforcement agency for approval with this to plan and specifications submitted to the enforcement agency for approval with this to plan and specifications submitted to the enforcement agency for approval with this to plan and specifications submitted to the enforcement agency for approval with this to plan and specifications submitted to the enforcement agency for approval with this to plan and specifications submitted to the enforcement agency for approval with this to plan and specifications submitted to the enforcement agency for approval with this to plan and specifications submitted to the enforcement agency for approval with this to plan and specifications submitted to the enforcement agency for approval with this to plan and specifications submitted to the enforcement agency for approval with this to plan and specifications submitted to the enforcement agency for approval wi	CALIFORNIA ENERGY COMMISSION CALIFORNIA ENERGY COMMISSION NRCC-LTH- nunications Wault Report Page: (Page 7 of 7/ Mountain Road Date Prepared: 4/26/2024 Mountain Road Date Prepared: 4/26/2024 Documentation Author Signature: Wike Johnston Signature Date: 2024-04-26 CEX/ HERS Certification Identification (if applicable): Phone: 707.544-7775 sibility for the building design or system design identified on this Certificate of Compliance (responsible designer) simufactured devices for the building design or system design identified on this Certificate of Compliance conform to the requirements of Compliance are consistent with the information provided on other applicable compliance documents, worksheets, calculations, building permit application. made available with the building permit(s) issued for the building, and made available to the enforcement agency for all applicable note is required to be included with the documentation the builder provides to the building owner at occupancy. Responsible Designet: 2024-04-26 License: E 15586 Phone:

Engineering Enterprises Inc.
Electrical Engineering and Designs
613 4th Street Suite 206b
Santa Rosa, Ca. 95404
(707) 544-7775
mike@engineering-enterprises.com

PINE MOUNTAIN ANTENNA COMMUNICATIONS BUILDING RECONSTRUCTION

ma County Facilities Development & Management

SHEET LOG
REV # DATE: ISSUED FOR

JOB NUMBER: SHEET:

TITLE 24 INDOOR LIGHTING

STATE OF CALIFORNIA Outdoor Lighting NRCC-LTO-E CERTIFICATE OF COMPLIANCE Project Name: Pine Mountain Communications Vault Report Page: (Page 1 of 7)	STATE OF CALIFORNIA Outdoor Lighting NRCC-LTO-E CERTIFICATE OF COMPLIANCE Project Name: Pine Mountain Communications Vault Report Page: (Page 2 of 7)	STATE OF CALIFORNIA Outdoor Lighting NRCC-LTO-E CERTIFICATE OF COMPLIANCE Project Name: Pine Mountain Communications Vault Report Page: CALIFORNIA ENERGY COMMISSION RECC-LTO-E (Page 3 of 7)
Residence Pine Mountain Road Date Prepared: 4/26/20/3	Project Address: Pine Mountain Road Date Prepared: 4/26/2024	F. OUTDOOR LIGHTING FIXTURE SCHEDULE
Outdoor Lighting NECCUTOR CERTIFICATE OF COMPUTANCE Pine Mountain Communications Vault Report Pages (Page 4 of 7) Project Address: Pine Mountain Road Date Propered: 4724/2024 H. OUTDOR LIGHTING CONTROLS This table demonstrates compliance with controls requirements for all new or altered luminaires installed as part of the permit application. For alteration projects, furninoires which are removed and reinstalled (wiring only) do not need to be included in this table even if they are within the spaces covered by the permit application. When any path busing a "is selected, the notes section of this table must be completed. The lighting controls section of the Compliance Summary Table on the first page will show "DCES NOT COMPLIA" (if the notes are left blank. Mandatory Controls 1 02 0 0 04 05 Area Description Shut-Off Auto-Schedule Motton Sensor Field Inspector Shad, 2(c) Shad, 2(c) Shad, 2(c) Shad, 2(c) Shad, 2(c) Shad, 2(c) Page Fall Main Entrance Photocontrol Yes Yes Pedestrian Hardscape Photocontrol Yes Yes Pedestrian Hardscape Photocontrol Yes Yes Pedestrian Hardscape Photocontrol Yes Yes	STATE OF CALIFORNIA Outdoor Lighting NECCIO-E CERTIFICATE OF COMPLIANCE Project Address: Pine Mountain Communications Vault Report Page: NECCITO-E Project Address: Pine Mountain Road Date Prepands: LIGHTING POWER ALLOWANCE (per \$140.7) This table includes arress using a flowance colculations per \$149.27. General Hardscape Allowance is per Table 140.7-A while "Use it or lose it" Allowances are per Table 140.7-A Allowances are being used to expand sections for user input. Luminorers In or lose it" allowances are being used to expand sections for user input. Luminorers In or lose it" allowance (select all that apply) (select all that appl	SYNTEOR CAURDINA Outdoor Lighting NECCHO-E PROJECT OF COMPLIANCE Project Name: Pine Mountain Communications valid [Report Page: Pine Mountain Road Date Prepared: NECHTO-E Project Address: Pine Mountain Road Date Prepared: NEXISTING CONDITIONS POWER ALLOWANCE (alterations only) This section does not apply to this project. Debt. CARATION OF REQUIRED CERTIFICATES OF INSTALLATION Selections have been made based on information provided in this document. If any selection have been changed by permit applicant, an explanation should be included in Table E. Additional Remarks. These documents must be provided to the building Inspector during construction and can be found online at https://www.energy.ca.gov/title/4/2019/stondards/2019_compliance_documents/NRC/ Form/Title Provided (RMCS), to be recognized for some provided of the selection have been danged by permit applicant, an explanation should be included in Table E. Additional Remarks. These documents must be provided for all buildings RECILITO-01-E - Must be submitted for all buildings NRCI-LTO-02-E - Must be submitted for all buildings Provider (ATTCP). For more information provided in this document, If any selection have been danged by permit applicant, an explanation should be included in Table E. Selections have been made based on information provided in this document, If any selection have been changed by permit applicant, an explanation should be included in Table E. Additional Remarks. These documents must be provided to the building inspector during construction and must be completed through on Acceptance Test Technician Certification Provider (ATTCP). For more information visit http://www.energy.ca.gov/title24/attcp/providers.html Form/Title System/Spaces To Be Field Field Inspector Fast Fail Inspector Fast Fathician Certification Fast Fail Inspecto
	This section does not apply to this project. M. LICHTING ALLOWANCE: PER SPECIFIC AREA This section does not apply to this project.	Outdoor Lighting Inscription Compliance of Compliance Prine Mountain Communications Vault Report Page: CALIFORNIA ENERGY COMMISSION INSCRIPTION AUTHORS DECLARATION STATEMENT Project Name: Prine Mountain Communications Vault Report Page: [Page 7 of 7] Project Address: Prine Mountain Road Date Prepared: 4/26/2024 DOCUMENTATION AUTHOR'S DECLARATION STATEMENT Certify that this Certificate of Compliance documentation is accurate and complete.

PINE MOUNTAIN ANTENNA COMMUNICATIONS BUILDING RECONSTRUCTION

County Facilities Development & Management

06.05.24 MICHAEL JOHNSTON NO. E 15586 EXP. 12-31-25

Wifes Johnston SHEET LOG

REV # DATE: ISSUED FOR

JOB NUMBER: SHEET:

TITLE 24 OUTDOOR LIGHTING