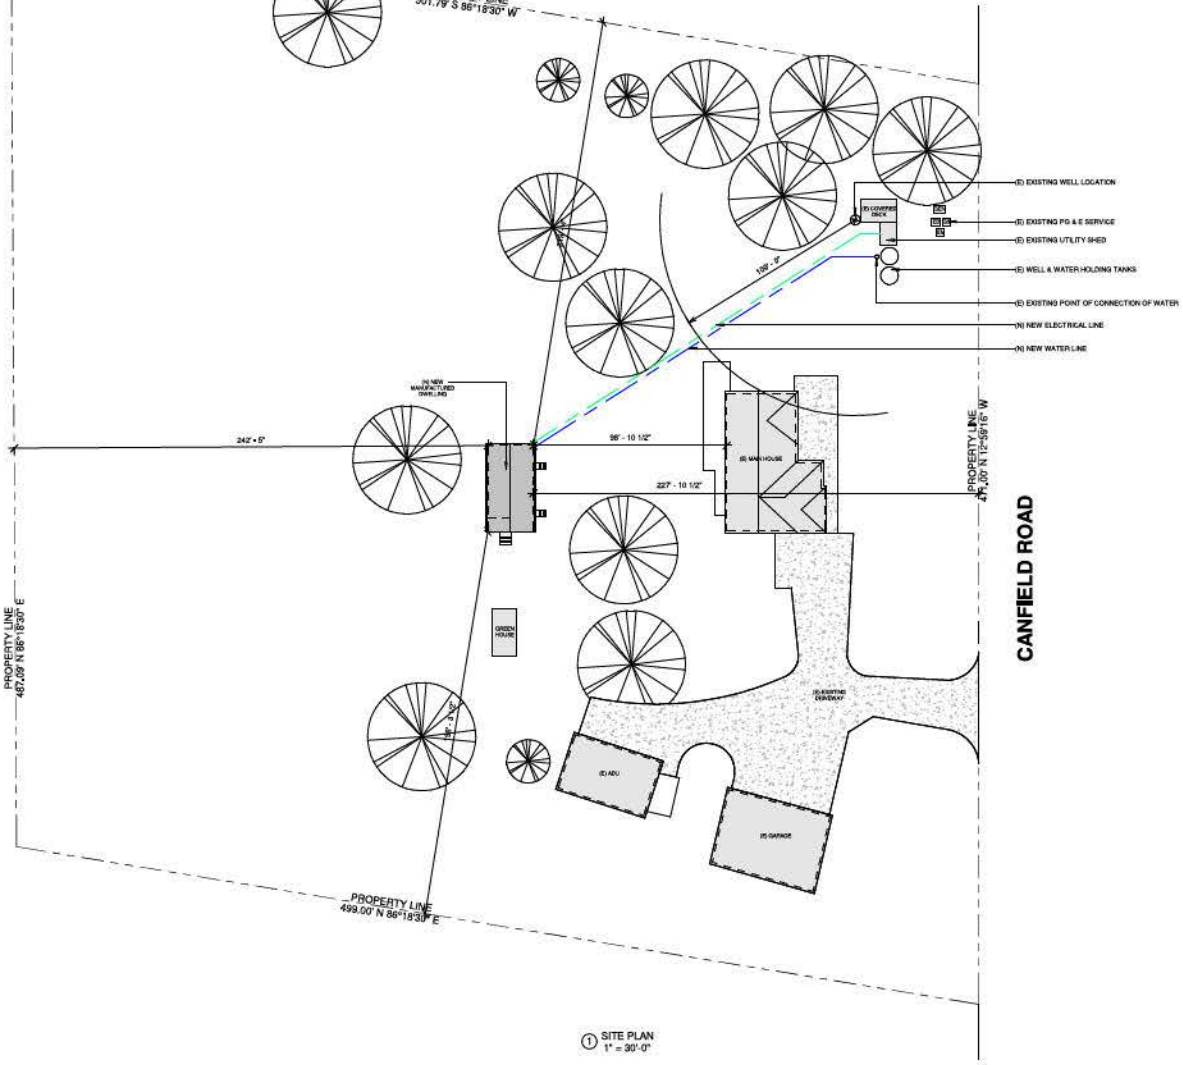

① SITE PLAN
1" = 30'-0"

0 15' 30' 60'
SCALE: 1" = 30'-0"

HARMONY Home IMPROVEMENTS

COPYRIGHT STATEMENT

THIS PLAN ALWAYS REMAINS THE COPYRIGHT OF DESIGNER, AND SHALL NOT BE USED OTHER THAN FOR THE PROJECT WORK INTENDED WITHOUT WRITTEN AUTHORITY. NO PART MAY BE REPRODUCED BY ANY PROCESS, NOR MAY ANY OTHER EXCLUSIVE RIGHT BE EXERCISED, WITHOUT PERMISSION. LEGAL ENFORCEMENT WILL BE TAKEN ON COPYRIGHT INFRINGEMENT.

NORTH ARROW

No.	Description	Date

OWNER:
Mike Glogovac

ADDRESS:
4018 Canfield Rd, Sebastopol, CA 95472

PROJECT NAME:
MANUFACTURED HOME

DRAWING TITLE
SITE PLAN

Project number	MH4018CR
Date	2024/12/12
Drawn by	CANIBUILD
Sheet No.:	A200
Scale	1" = 30'-0"

POWERED BY CANIBUILD

RECORD PLANS 05/30/23

LANDS OF GLOGOVAC

Site Plan

4018 CANFIELD ROAD
SEBASTOPOL
A.P.N.:025-090-011

Huffman Engineering & Surveying
837 College Avenue., Suite A
Santa Rosa, Ca. 95404
P:(707) 542-6589
www.huffmanengineering.net

#	Description	Date
1	RECORD PLANS	05/30/23

Engineer: Robert Huffman P.E. 42293 05/30/23

Date: 05/30/23	Scale: 1" = 30'
File: 21-084	Sheet 3
Dwg: KOD	
Job: 21-084	Of 8 Sheets

FOR REDUCED PLANS, THE ORIGINAL SCALE IS IN INCHES 0 1 2 3